

GENERAL NOTES FOR EQUIPMENT VENDOR:

- THIS CONTRACT IS FOR INSTALLATION WORK OF FACILITIES.
- DIMENSIONS AND INSTALLATION CLEARANCES AS SHOWN ARE APPROXIMATE AND WILL NECESSARILY VARY DEPENDING ON FINAL DIMENSIONS OF FURNISHED EQUIPMENT. MINOR DEVIATIONS IN EQUIPMENT LOCATIONS AND CLEARANCES WILL BE CONSIDERED DURING SHOP DRAWING REVIEW BY WMATA.
- FOR TYPICAL DETAILS SEE DRAWINGS TP-G-006 THROUGH TP-G-010.
- INSTALL AND GROUND RACEWAYS, CONDUITS, AND EQUIPMENT PER NATIONAL ELECTRICAL CODE AND AS INDICATED (DC SWITCHGEAR AND POSITIVE CABLE TRAY ARE NOT GROUNDED).
- ALL BOLTED CONNECTIONS FOR CURRENT CARRYING CONDUCTORS SHALL BE MADE WITH NON-FERROUS WASHERS AND HEX HEAD BOLTS AND NUTS. MATERIALS SHALL BE COMPATIBLE WITH CONNECTORS AND LUGS.
- THIS CONTRACT SHALL INCLUDE AT NO ADDITIONAL COST TO THE AUTHORITY. THE RELOCATION AND RECONNECTION OF ELECTRICAL EQUIPMENT IN THE SUBSTATION INCLUDING (BUT NOT LIMITED TO) EXISTING TRANSFORMER, PANELS, CIRCUIT BREAKERS, SWITCHES, CONDUITS, GROUND BUSES, LIGHTING FIXTURES, UPS, BATTERIES, AND ANCILLARY EQUIPMENT INCLUDING MECHANICAL DUCTS, EYE WASH UNITS, ETC. AS REQUIRED TO INSTALL MATERIALS SHOWN ON THE CONTRACT DRAWINGS. ALL WORK SHALL HAVE PRIOR APPROVAL FROM WMATA ENGINEERING.
- LOCATION OF PANELBOARDS, TEST CABINETS, AND OTHER WALL MOUNTED EQUIPMENT ARE APPROXIMATE. CONTRACTOR SHALL VERIFY CLEARANCES AND INTERFERENCE BY FIELD SURVEY AND RELOCATE IF NECESSARY TO SUIT FIELD CONDITIONS. ALL WORK SHALL HAVE PRIOR APPROVAL FROM THE ENGINEER.
- EXCEPT WHERE OTHERWISE SHOWN ON THE DRAWINGS THE MOUNTING HEIGHT TO THE TOP OF NEW ELECTRICAL EQUIPMENT ABOVE THE FLOOR INSTALLED IN TBS SHALL BE AS FOLLOWS:

HMI - 5'-6"
DISCONNECT SWITCH 5'-6"
DC/AC CIRCUIT BREAKER TEST CABINET 5'-0"
ENCLOSED CIRCUIT BREAKER 5'-6"
DC DISTRIBUTION PANEL 6'-0"
AC POWER PANEL 6'-0"
BATTERY CYCLE MONITOR - 6'-0"

WALL MOUNTED
ALL STATIONS

BATTERY CHARGER & BATTERY
DC SWITCHGEAR
VOLTAGE REGULATOR
RTU

FLOOR MOUNTED
ALL STATIONS

- MINIMUM VERTICAL CLEARANCE OF CABLE TRAYS FROM TOP OF LOWER TRAY TO BOTTOM OF UPPER TRAY SHALL BE 12" WHERE RUNNING PARALLEL (ONE ABOVE THE OTHER) AND 6" WHERE CROSSING.
- RACEWAY RUNS AND CABLE TRAY LOCATIONS ARE SHOWN DIAGRAMMATICALLY. EXACT LOCATIONS AND METHOD OF SUPPORT SHALL BE DETERMINED AND PROVIDED BY THE CONTRACTOR. WORK SHALL HAVE PRIOR APPROVAL FROM THE WMATA ENGINEER.
- ALL EQUIPMENT LAYOUT AND CLEARANCES SHOWN ON THESE CONTRACT DRAWINGS ARE BASED UPON MAXIMUM PERMISSIBLE DIMENSIONS OF VENDOR EQUIPMENT. THESE LAYOUTS SHALL BE ADJUSTED, BASED UPON ACTUAL FURNISHED EQUIPMENT WHERE NECESSARY AND SUBMITTED TO AUTHORITY REPRESENTATIVE FOR APPROVAL.
- ALL DIMENSIONS SHOWN FOR CLEARANCES TO WALLS, OPENINGS AND OTHER EQUIPMENT ARE MINIMUM AND MUST BE MAINTAINED. CONTRACTOR SHALL OBTAIN APPROVAL OF AUTHORITY REPRESENTATIVE IF A REVISION IN THE EQUIPMENT LAYOUT IS REQUIRED TO ACCOMMODATE THE EQUIPMENT FURNISHED.
- ALL DIMENSIONS SHOWN ARE APPROXIMATE. EXACT MEASUREMENTS SHALL BE MADE AT THE SITE BY CONTRACTOR/DESIGNER.
- INSULATING TOPPING SHALL BE PROVIDED AS SHOWN WITH A MINIMUM OF 3'-0" AROUND DC SWITCHGEAR AND 4'-6" IN FRONT OF DC SWITCHGEAR.
- REPLACED LIGHTING FIXTURES SHALL BE INSTALLED AS SHOWN ON CONTRACT DRAWINGS.
- PROVIDE 2#12 & 1#12G IN 3/4"C FOR NEW AND REPLACED LIGHTING FIXTURE BRANCH CIRCUITS. ALL NORMAL LIGHT FIXTURES INSIDE TBS ROOMS ARE TYPE 1. EMERGENCY LIGHT FIXTURES ARE TYPE 10. OUTDOOR LIGHT FIXTURES ARE TYPE 8.
- PROVIDE/REPLACE STATION SWITCHES FOR LIGHTING FIXTURES FOR ALL FACILITIES.
- THE TEMPORARY JUMPER CONNECTION CONSISTS OF FOUR (4) 1000KCM UNSHIELDED CABLE AS STIPULATED IN SPECIFICATION SECTION 16128 UNLESS OTHERWISE NOTED.
- ONE LINE DIAGRAMS SHOWN ARE FOR GUIDANCE ONLY.

- FIELD VISIT AND TESTING INFORMATION IS REQUIRED PRIOR TO ANY MODIFICATIONS.
- ALL WORK SHOULD BE PERFORMED IN ACCORDANCE WITH LOCAL CODE AND NEC. WHERE LOCAL CODE AND NEC IS PERMISSIVE, THE SPECIFICATION GOVERN. LOCAL AUTHORITY GOVERNS ALL.
- CONTRACTOR SHALL REPLACE OR RESTORE TO ORIGINAL CONDITION EXISTING EQUIPMENT AND MATERIAL DAMAGE BY THE CONTRACTOR DURING THE COURSE OF THIS CONTRACT AT NO ADDITIONAL COST TO WMATA.
- DIRECTORIES OF EXISTING PANELBOARDS MODIFIED BY THE CONTRACTOR SHALL BE REPLACED WITH NEW TYPED DIRECTORIES IDENTIFYING THE UPDATED CIRCUITS.
- ALL NEW POSITIVE CABLE TRAY SHALL BE FIBERGLASS, AS MANUFACTURED BY ROBROY INDUSTRIES OR APPROVED EQUAL.
- THE REQUIREMENTS FOR CONDUIT, CABLE, AND WIRING ARE SHOWN ON PLANS, DETAILS, ONE LINE DIAGRAMS, WIRING DIAGRAMS, AND/OR SCHEDULES. THE CONTRACTOR SHALL ALSO REFER TO THE APPROPRIATE SPECIFICATION AND DESIGN CRITERIA TO DETERMINE THE MATERIAL QUANTITY AND INSTALLATION REQUIREMENTS.
- FILL DEPRESSED FLOOR AREAS IN AREAS WHERE NO INSULATED TOPPING IS INSTALLED WITH CONCRETE TO PROVIDE FINISH FLOOR SURFACE FLUSH WITH ADJACENT FINISHED FLOOR SURFACED.
- WHERE INSULATING TOPPING IS INSTALLED ON FINISHED FLOOR, FEATHER EDGES TO MEET THE UN-TOPPED FLOOR SURFACE WITHOUT PRESENTING A RIDGE ON THE FLOOR.
- ALL UNGROUNDED EQUIPMENT, SUCH AS DC SWITCHGEAR ARE REQUIRED TO BE INSTALLED AT A MINIMUM OF 3' CLEARANCE FROM GROUNDED EQUIPMENT, WALLS, AND COLUMNS. WHERE SPACE IS LESS THAN 3'-0", INSULATED SHEETS ON WALLS AND COLUMNS SHALL BE INSTALLED FROM FLOOR TO MINIMUM HEIGHT OF 12" ABOVE HEIGHT OF RESPECTIVE EQUIPMENT.
- ANY ENLARGEMENT OF EXISTING OPENINGS IN WALL OR FLOOR SHALL BE COORDINATED WITH APPROVED SHOP DRAWINGS FROM VENDOR AND DETAILS SUBMITTED TO ENGINEER FOR APPROVAL.
- WHERE EXISTING EQUIPMENT SUCH AS DC SWITCHGEAR IS REPLACED. CONTRACTOR IS REQUIRED TO PROVIDE NECESSARY MOUNTING AND LEVELING CHANNELS, HARDWARE, FOUNDATION BOLTS AND OTHER SIMILAR ITEMS. EXISTING EMBEDDED FLOOR CHANNELS MAY BE REUSED.
- SOME WIRING AND CIRCUIT CONFIGURATIONS/ROUTING AS SHOWN ON DRAWINGS MAY REQUIRE REVISION BASED ON VENDOR DRAWINGS. CONTRACTOR SHALL REFLECT THESE CHANGES AS WELL AS INCORPORATE THEM INTO AS-BUILT DRAWINGS AT NO ADDITIONAL COST TO THE AUTHORITY.
- PROVIDE NEW CABLES AS INDICATED ON CABLE SCHEDULES.
- PROVIDE NEW CONDUITS. NEW CONDUITS SHALL BE GALVANIZED RIGID STEEL (EXCEPT PROVIDE FRE NON-METALLIC CONDUIT FOR FINAL CONNECTION TO DC SWITCHGEAR, DC SWITCHBOARDS, AND RECTIFIERS).
- PROVIDE AND INSTALL WIRING AS DEFINED IN CABLE SCHEDULE ALL EXISTING CIRCUITS IN CABLE SCHEDULE ARE TO REMAIN UNLESS OTHERWISE NOTED.
- THE CONTRACTOR SHALL INSTALL ALL IDENTIFIED EQUIPMENT SHOWN ON CONTRACT DRAWINGS. THE WORK SHALL BE IN ACCORDANCE WITH DESIGN CRITERIA AND SPECIFICATION.
- THE CONTRACTOR SHALL DEVELOPED DETAILED INSTALLATION DRAWINGS, INTERCONNECTION DRAWINGS, CABLE SCHEDULE, DTS INTERCONNECTION DIAGRAMS BASED ON CONTRACT DRAWINGS AND SUBMITTED TO WMATA FOR APPROVAL.
- VENDOR DRAWINGS FOR EACH FACILITY WILL BE PROVIDED BY WMATA TO THE EXTENT POSSIBLE, AS THE CONTRACT PROGRESSES. THESE DRAWINGS ARE NOT CONFORMED OR FIELD VERIFIED. THE CONTRACTOR SHALL ASSURE THE SUITABILITY OF THESE VENDOR DRAWINGS TO PERFORM THE REQUIRED WORK BY APPROPRIATE FILED SURVEY AND CHECKS.
- FOR 5 TBS LOCATIONS (EXCEPT G01TBS), REPLACE 5 RECEPTACLES AND BRANCH CIRCUIT WIRING. BRANCH CIRCUIT LENGTH IS 130FT AT EACH LOCATION. EXISTING CONDUIT MAY BE REUSED UNLESS RUSTED OR CORRODED.
- THE BRANCH CIRCUIT WIRING LENGTH IS 80 FEET FOR EACH UNIT HEATERS AND EXHAUST FANS.
- EXTERIOR LIGHT INDICATED ON PLANS IS THE EXTERIOR LIGHT ABOVE THE DOOR AT TBS ENTRANCE.
- PLANS AND ELEVATIONS ARE APPROX. 1/4"=1'-0" AND NOT EXACT DUE TO FITTING AND PRINTING ON 11"x17" PAPER. ALSO, ALL DIMENSIONS ON THE PLANS AND ELEVATIONS ARE APPROXIMATE.
- THE NEGATIVE POLARITY JUNCTION BOXES ARE LOCATED WITHIN THE TBS ROOM AND THE BRANCH CIRCUIT LENGTH IS 60FT PER EACH OF 2 TRACK NEGATIVE REFERENCES.

*** PROVIDE = THE PROVISION OF NEW EQUIPMENT, INSTALLATION, TESTING, MOUNTING AND CONNECTIONS REQUIRED FOR A FULLY FUNCTIONAL INSTALLATION. ***

ABBREVIATIONS

- | | |
|--|------------------------------------|
| 3PH - THREE PHASE | PT - POTENTIAL TRANSFORMER |
| AEMS - AUTOMATED ENERGY MANAGEMENT SYSTEM | PWR - POWER |
| A.F.F. - INDICATES MOUNTING HEIGHT ABOVE FINISHED FLOOR TO BOTTOM OF EQUIPMENT | RTU - REMOTE TERMINAL UNIT |
| ATS - AUTOMATIC TRANSFER SWITCH | SWGR. - SWITCHGEAR |
| AUX, - AUXILIARY | SW. - SWITCH |
| AVR - AUTOMATIC VOLTAGE REGULATOR | TBS - TIE BREAKER STATION |
| BKR - BREAKER | TYP. - TYPICAL |
| CA. TRAY - CABLE TRAY | UPS - UNINTERRUPTIBLE POWER SUPPLY |
| CAB - CABINET | W - WIDTH |
| CKT. - CIRCUIT | XDCR - TRANSDUCER |
| CB - CIRCUIT BREAKER | XFMR - TRANSFORMER |
| CND. - CONDUIT | |
| CT - CURRENT TRANSFORMER | |
| CSM - CABLE SHIELD MONITOR | |
| DIO - DISTRIBUTED INPUT/OUTPUT MODULE | |
| DPM - DIGITAL POWER METER | |
| DTR - DIGITAL TRACE RECORDER | |
| D.T.S. - DATA TRANSMISSION SYSTEM OR SUPERVISORY CONTROL TERMINAL BOX | |
| EMERG. - EMERGENCY | |
| EQUIP. - EQUIPMENT | |
| ECB - ENCLOSED CIRCUIT BREAKER | |
| FDR - FEEDER | |
| FPP/FDP - FIBER PATCH PANEL/FIBER DISTRIBUTION PANEL | |
| HMI - HUMAN MACHINE INTERFACE | |
| I.B. - INBOUND TRACK | |
| INCOM - INCOMING | |
| J.B. - JUNCTION BOX | |
| KV - KILOVOLTS | |
| KVA - KILOVOLT AMPERES | |
| KW - KILOWATTS | |
| - LENGTH | |
| LV - LOW VOLTAGE | |
| MTD - MOUNTED | |
| MPR - MULTIFUNCTION PROTECTION RELAY | |
| MW - MEGA WATTS | |
| NEG - NEGATIVE | |
| N.I.C. - NOT IN CONTRACT | |
| NO. - NUMBER | |
| O.B. - OUTBOUND TRACK | |
| OCC - OPERATION CONTROL CENTER | |
| PNL - PANEL | |
| POS - POSITIVE | |



"PROFESSIONAL CERTIFICATION: I HEREBY CERTIFY THAT THESE DOCUMENTS WERE PREPARED OR APPROVED BY ME, AND THAT I AM A DULY LICENSED PROFESSIONAL ENGINEER UNDER THE LAWS OF THE COMMONWEALTH OF VIRGINIA."

LICENSE No. 04020117145
EXPIRATION DATE: 10/31/2015

-VA Regulations 18VAC10-20-760

Drawing File: H:\WMATA PROJECTS\FQ15237\DRAWING\TBS-G-003.DWG
 Plotted by: E013941 Date: Fri, 30 Oct 2015 Time: 10:45:29 am
 Xrefs: N:\ROBINSON-ELECT-MECH\ELEC-MECH-PWR AutoCAD Folder\WMATA CAD TEMPLATE\Library\CUIPTA SIGNATURE.tif

DESIGNED			DRAWN			CHECKED		
JAJ	4/4/15	DATE	JAJ	5/20/15	DATE	PK	6/1/15	DATE

REFERENCE DRAWINGS		REVISIONS		
NUMBER	TITLE	DATE	NUM	DESCRIPTION
		11/2/15	1	AMENDMENT NO. 1

WASHINGTON METROPOLITAN AREA TRANSIT AUTHORITY
 metro

DEPARTMENT OF TRANSIT INFRASTRUCTURE AND ENGINEERING SERVICES
 CENI - POWER SYSTEMS ENGINEERING

REVISION SUBMITTED _____ DATE _____ APPROVED _____ DATE _____
 DEPUTY CHIEF ENGINEER

SIX (6) TIE BREAKER STATIONS UPGRADES ORANGE AND BLUE LINES DC, MD AND VA			
GENERAL NOTES AND ABBREVIATIONS			
CONTRACT NO. FQ15237	SCALE NONE	DRAWING NO. TBS-G-003	SHEET NO. 3 OF 60


CABLE										CIRCUIT				ROUTING				CABLE										CIRCUIT				ROUTING									
NUMBER	CONSTRUCT.	SIZE AWG	INSULATION		VOLTAGE	A.C. OR D.C.	SPARE COND.	FROM	VIA	TO	FOR	REV. NO.	NUMBER	CONSTRUCT.	SIZE AWG	INSULATION		VOLTAGE	A.C. OR D.C.	SPARE COND.	FROM	VIA	TO	FOR	REV. NO.	NUMBER	CONSTRUCT.	SIZE AWG	INSULATION		VOLTAGE	A.C. OR D.C.	SPARE COND.	FROM	VIA	TO	FOR	REV. NO.			
DP-1	5-1/C	1000 MCM	1000V	90°C	700V	DC	0	DC SWITCHGEAR UNIT NO.1 BKR. #3	CABLE TRAY & CONDUIT	CONTACT RAIL I.B. END APPR. 509+00.25	TRACTION POWER FEEDER	0	DC-1	2-1/C	#4	600V	90°C	125V	DC	0	BATTERY CHARGER	CONDUIT	NEW 200A ENCLOSED CIRCUIT BREAKER	BATTERY CHARGING DC FEEDER	0	DC-2	2-1/C	#3/0	600V	90°C	125V	DC	0	NEW 200A ENCLOSED CIRCUIT BREAKER	CONDUIT	BATTERY	DC POWER FEEDER	0			
DP-2	4-1/C	1000 MCM	1000V	90°C	700V	DC	0	DC SWITCHGEAR UNIT NO.2 BKR. #1	CABLE TRAY & CONDUIT	CONTACT RAIL I.B. END APPR. 508+44.25	TRACTION POWER FEEDER	0	DC-3	2-1/C	#3/0	600V	90°C	125V	DC	0	NEW 200A ENCLOSED CIRCUIT BREAKER	CONDUIT	DC DISTRIBUTION PANEL DC-IGS	DC POWER FEEDER	0	DC-4	2/C	#12	600V	90°C	125V	DC	0	DC DISTRIBUTION PANEL DC-IGS	CONDUIT	HMI CABINET	DC POWER	0			
DP-3	4-1/C	1000 MCM	1000V	90°C	700V	DC	0	DC SWITCHGEAR UNIT NO.3 BKR. #2	CABLE TRAY & CONDUIT	CONTACT RAIL O.B. END APPR. 508+33.59	TRACTION POWER FEEDER	0	DC-5	2/C	#6	600V	90°C	125V	DC	0	DC DISTRIBUTION PANEL DC-IGS	CABLE TRAY & CONDUIT	DC SWITCHGEAR UNIT NO.1 BKR. #3	DC POWER	0	DC-6	2/C	#10	600V	90°C	125V	DC	0	DC DISTRIBUTION PANEL DC-IGS	CABLE TRAY & CONDUIT	DC CKT. BKR. TEST CABINET	DC POWER	0			
DP-4	4-1/C	1000 MCM	1000V	90°C	700V	DC	0	DC SWITCHGEAR UNIT NO.4 BKR. #4	CABLE TRAY & CONDUIT	CONTACT RAIL O.B. END APPR. 508+33.59	TRACTION POWER FEEDER	0	DC-7	2/C	#10	600V	90°C	125V	DC	0	DC DISTRIBUTION PANEL DC-IGS	CONDUIT	EMERT. TRIP SW. RELAY CABLE	DC POWER	0	DC-8	2/C	#10	600V	90°C	125V	DC	0	DC DISTRIBUTION PANEL DC-IGS	CABLE TRAY & CONDUIT	NETWORK SWITCH	DC POWER	0			
AN-1	4/C	#14	600V	90°C	125V	DC	2	BATTERY CHARGER	CABLE TRAY & CONDUIT	RTU	BATTERY CHARGER ANNUNCIATION	0	DC-9	2/C	#12	600V	90°C	125V	DC	0	DC DISTRIBUTION PANEL DC-IGS	CABLE TRAY & CONDUIT	EMERGENCY LIGHT	DC POWER	0	DC-10	2/C	#12	600V	90°C	125V	DC	0	DC DISTRIBUTION PANEL DC-IGS	CABLE TRAY & CONDUIT	RTU	DC POWER	0			
AN-2	NOT USED												ET-1	4/C	#10	600V	90°C	125V	DC	2	EMER. TRIP SWITCH RELAY CABINET	CABLE TRAY & CONDUIT	DC SWITCHGEAR UNIT NO.1 BKR. #3	CONTACT RAIL EMER. TRIP	0	ET-2	4/C	#10	600V	90°C	125V	DC	2	EMER. TRIP SWITCH RELAY CABINET	CABLE TRAY & CONDUIT	DC SWITCHGEAR UNIT NO.2 BKR. #1	CONTACT RAIL EMER. TRIP	0			
AN-3	12/C	#14	600V	90°C	125V	DC	3	ETS RELAY CABINET	CABLE TRAY & CONDUIT	RTU	ETS ANNUNCIATION	0	ET-3	4/C	#10	600V	90°C	125V	DC	2	EMER. TRIP SWITCH RELAY CABINET	CABLE TRAY & CONDUIT	DC SWITCHGEAR UNIT NO.3 BKR. #2	CONTACT RAIL EMER. TRIP	0	ET-4	4/C	#10	600V	90°C	125V	DC	2	EMER. TRIP SWITCH RELAY CABINET	CABLE TRAY & CONDUIT	DC SWITCHGEAR UNIT NO.4 BKR. #4	CONTACT RAIL EMER. TRIP	0			
AN-4	NOT USED												SC-1	12/C	#14	600V	90°C	24V	DC	4	DC SWITCHGEAR UNIT NO.1 BKR. #3	CABLE TRAY & CONDUIT	DATA TRANSMISSION SYSTEM CABINET	CIRCUIT BREAKER CONTROL & INDICATION	0	SC-2	12/C	#14	600V	90°C	24V	DC	4	DC SWITCHGEAR UNIT NO.2 BKR. #1	CABLE TRAY & CONDUIT	DATA TRANSMISSION SYSTEM CABINET	CIRCUIT BREAKER CONTROL & INDICATION	0			
SC-1	12/C	#14	600V	90°C	24V	DC	4	DC SWITCHGEAR UNIT NO.1 BKR. #3	CABLE TRAY & CONDUIT	DATA TRANSMISSION SYSTEM CABINET	CIRCUIT BREAKER CONTROL & INDICATION	0	SC-3	12/C	#14	600V	90°C	24V	DC	4	DC SWITCHGEAR UNIT NO.3 BKR. #2	CABLE TRAY & CONDUIT	DATA TRANSMISSION SYSTEM CABINET	CIRCUIT BREAKER CONTROL & INDICATION	0	SC-4	12/C	#14	600V	90°C	24V	DC	4	DC SWITCHGEAR UNIT NO.4 BKR. #4	CABLE TRAY & CONDUIT	DATA TRANSMISSION SYSTEM CABINET	CIRCUIT BREAKER CONTROL & INDICATION	0			
SC-2	12/C	#14	600V	90°C	24V	DC	4	DC SWITCHGEAR UNIT NO.2 BKR. #1	CABLE TRAY & CONDUIT	DATA TRANSMISSION SYSTEM CABINET	CIRCUIT BREAKER CONTROL & INDICATION	0	SC-5	NOT USED												SC-6	NOT USED														
SC-3	12/C	#14	600V	90°C	24V	DC	4	DC SWITCHGEAR UNIT NO.3 BKR. #2	CABLE TRAY & CONDUIT	DATA TRANSMISSION SYSTEM CABINET	CIRCUIT BREAKER CONTROL & INDICATION	0	SC-7	19/C	#14	600V	90°C	24V	DC	7	RTU CABINET	CABLE TRAY & CONDUIT	DATA TRANSMISSION SYSTEM CABINET	ANNUNCIATION	0	AC-1	4/C	#10	600V	90°C	480V	AC	0	1 GREEN GRD WIRE	NEW 480V/277V AC PANEL GT-H	CONDUIT	UNIT HEATER #1	A.C. POWER	0		
SC-4	12/C	#14	600V	90°C	24V	DC	4	DC SWITCHGEAR UNIT NO.4 BKR. #4	CABLE TRAY & CONDUIT	DATA TRANSMISSION SYSTEM CABINET	CIRCUIT BREAKER CONTROL & INDICATION	0	AC-2	4/C	#10	600V	90°C	480V	AC	0	1 GREEN GRD WIRE	NEW 480V/277V AC PANEL GT-H	CONDUIT	UNIT HEATER #2	A.C. POWER	0	AC-3	4/C	#10	600V	90°C	480V	AC	0	1 GREEN GRD WIRE	NEW 480V/277V AC PANEL GT-H	CONDUIT	BATTERY CHARGER	BATTERY CHARGER POWER SUPPLY	0	
SC-5	NOT USED												AC-4	2/C	#12	600V	90°C	277V	AC	0	1 GREEN GRD WIRE	NEW 480V/277V AC PANEL GT-H	CONDUIT	INDOOR LIGHTING	A.C. POWER	0	AC-5	4/C	#10	600V	90°C	480V	AC	0	1 GREEN GRD WIRE	NEW 480V/277V AC PANEL GT-H	CONDUIT	NEW 15KVA TRANSFORMER	A.C. POWER	0	
SC-6	NOT USED												AC-6	4/C	#6	600V	90°C	208V	AC	0	1 GREEN GRD WIRE	NEW 15KVA TRANSFORMER	CONDUIT	NEW 208V/120V AC PANEL GT-L	A.C. POWER	0	AC-7	3/C	#12	600V	90°C	120V	AC	0	1 GREEN GRD WIRE	NEW 208V/120V AC PANEL GT-L	CONDUIT	NEW 3KVA ISOLATION TRANSFORMER	A.C. POWER	0	
SC-7	19/C	#14	600V	90°C	24V	DC	7	RTU CABINET	CABLE TRAY & CONDUIT	DATA TRANSMISSION SYSTEM CABINET	ANNUNCIATION	0	AC-8	2/C	#12	600V	90°C	120V	AC	0		ISOLATION TRANSFORMER	CONDUIT	DC SWITCHGEAR UNIT NO.1	A.C. POWER D.C. SWGR HEATER	0	AC-9	2/C	#10	600V	90°C	120V	AC	0	1 GREEN GRD WIRE	NEW 208V/120V AC PANEL GT-L	CONDUIT	EXHAUST FAN #1	A.C. POWER	0	
AC-1	4/C	#10	600V	90°C	480V	AC	0	1 GREEN GRD WIRE	NEW 480V/277V AC PANEL GT-H	CONDUIT	UNIT HEATER #1	A.C. POWER	0	AC-10	2/C	#10	600V	90°C	120V	AC	0	1 GREEN GRD WIRE	NEW 208V/120V AC PANEL GT-L	CONDUIT	EXHAUST FAN #2	A.C. POWER	0	AC-11	2/C	#12	600V	90°C	120V	AC	0	1 GREEN GRD WIRE	NEW 208V/120V AC PANEL GT-L	CONDUIT	RECEPTACLES	A.C. POWER	0
AC-2	4/C	#10	600V	90°C	480V	AC	0	1 GREEN GRD WIRE	NEW 480V/277V AC PANEL GT-H	CONDUIT	UNIT HEATER #2	A.C. POWER	0	AC-12	2/C	#12	600V	90°C	120V	AC	0	1 GREEN GRD WIRE	NEW 208V/120V AC PANEL GT-L	CONDUIT	OUTDOOR LIGHTING	A.C. POWER	0	AC-13	2/C	#12	600V	90°C	120V	AC	0	1 GREEN GRD WIRE	NEW 208V/120V AC PANEL GT-L	CONDUIT	RTU	A.C. POWER	0
AC-3	4/C	#10	600V	90°C	480V	AC	0	1 GREEN GRD WIRE	NEW 480V/277V AC PANEL GT-H	CONDUIT	BATTERY CHARGER	BATTERY CHARGER POWER SUPPLY	0	AC-14	2/C	#12	600V	90°C	120V	AC	0	1 GREEN GRD WIRE	NEW 208V/120V AC PANEL GT-L	CONDUIT	NEW BATTERY CYCLE MONITOR	A.C. POWER	0	MA-1	1-1/C	#6	2000V	90°C	GRD.	0	DC SWITCHGEAR UNIT NO.1 BKR. #3	CONDUIT	STATION GROUND	LIGHTING ARRESTER GROUND	0		
AC-4	2/C	#12	600V	90°C	277V	AC	0	1 GREEN GRD WIRE	NEW 480V/277V AC PANEL GT-H	CONDUIT	INDOOR LIGHTING	A.C. POWER	0	MA-2	1-1/C	#6	2000V	90°C	GRD.	0	DC SWITCHGEAR UNIT NO.2 BKR. #1	CONDUIT	STATION GROUND	LIGHTING ARRESTER GROUND	0	MA-3	1-1/C	#6	2000V	90°C	GRD.	0	DC SWITCHGEAR UNIT NO.3 BKR. #2	CONDUIT	STATION GROUND	LIGHTING ARRESTER GROUND	0				
AC-5	4/C	#10	600V	90°C	480V	AC	0	1 GREEN GRD WIRE	NEW 480V/277V AC PANEL GT-H	CONDUIT	NEW 15KVA TRANSFORMER	A.C. POWER	0	MA-4	1-1/C	#6	2000V	90°C	GRD.	0	DC SWITCHGEAR UNIT NO.4 BKR. #4	CONDUIT	STATION GROUND	LIGHTING ARRESTER GROUND	0	MA-5	2/C	#10	600V	90°C	GRD.	0	DC SWITCHGEAR UNIT NO.1 BKR. #3	CABLE TRAY & CONDUIT	STATION GROUND	GROUND RELAYING	0				
AC-6	4/C	#6	600V	90°C	208V	AC	0	1 GREEN GRD WIRE	NEW 15KVA TRANSFORMER	CONDUIT	NEW 208V/120V AC PANEL GT-L	A.C. POWER	0	MA-6	1/C	#10	2000V	90°C	700V	0	DC SWITCHGEAR UNIT NO.1 BKR. #3	CONDUIT	NEGATIVE POLARITY	NEG. POLARITY REFERENCE I.B.	0	MA-7	1/C	#10	2000V	90°C	700V	0	DC SWITCHGEAR UNIT NO.4 BKR. #4	CONDUIT	NEGATIVE POLARITY	NEG. POLARITY REFERENCE O.B.	0				
AC-7	3/C	#12	600V	90°C	120V	AC	0	1 GREEN GRD WIRE	NEW 208V/120V AC PANEL GT-L	CONDUIT	NEW 3KVA ISOLATION TRANSFORMER	A.C. POWER	0																												
AC-8	2/C	#12	600V	90°C	120V	AC	0		ISOLATION TRANSFORMER	CONDUIT	DC SWITCHGEAR UNIT NO.1	A.C. POWER D.C. SWGR HEATER	0																												
AC-9	2/C	#10	600V	90°C	120V	AC	0	1 GREEN GRD WIRE	NEW 208V/120V AC PANEL GT-L	CONDUIT	EXHAUST FAN #1	A.C. POWER	0																												
AC-10	2/C	#10	600V	90°C	120V	AC	0	1 GREEN GRD WIRE	NEW 208V/120V AC PANEL GT-L	CONDUIT	EXHAUST FAN #2	A.C. POWER	0																												
AC-11	2/C	#12	600V	90°C	120V	AC	0	1 GREEN GRD WIRE	NEW 208V/120V AC PANEL GT-L	CONDUIT	RECEPTACLES	A.C. POWER	0																												
AC-12	2/C	#12	600V	90°C	120V	AC	0	1 GREEN GRD WIRE	NEW 208V/120V AC PANEL GT-L	CONDUIT	OUTDOOR LIGHTING	A.C. POWER	0																												
AC-13	2/C	#12	600V	90°C	120V	AC	0	1 GREEN GRD WIRE	NEW 208V/120V AC PANEL GT-L	CONDUIT	RTU	A.C. POWER	0																												
AC-14	2/C	#12	600V	90°C	120V	AC	0	1 GREEN GRD WIRE	NEW 208V/120V AC PANEL GT-L	CONDUIT	NEW BATTERY CYCLE MONITOR	A.C. POWER	0																												

H - A.C. PRIMARY VOLTAGE CABLE
 DP - D.C. POSITIVE POWER CABLE
 DN - D.C. NEGATIVE POWER CABLE
 DD - D.C. UTILITY DRAIN CABLE
 AN - ANNUNCIATOR CABLE
 SC - SUPERVISORY CONTROL CABLE
 ET - EMERGENCY TRIP CABLE
 MT - METERING & INSTRUMENTATION CABLE
 CN - OPERATING CONTROL CABLE
 MA - MISCELLANEOUS CIRCUITS
 AC - A.C. LOW VOLTAGE POWER CIRCUITS
 DC - D.C. CONTROL POWER CIRCUITS

REFERENCE DRAWINGS			REVISIONS		
NUMBER	TITLE	DATE	NUM	DESCRIPTION	
		11/2/15	1	AMENDMENT NO. 1	


END APPR - END APPROACH OF CONTACT RAIL
 CSM - CABLE SHIELD MONITORING CABLE
***** BOLD TEXT INDICATES NEW CABLES**
 *** SCREENED TEXT INDICATES EXISTING TO REMAIN CABLES

NOTE:
 AN-1, AN-3, SC-7, AC-13, AC-14, DC-4, DC-8, DC-10 ARE SHOWN ON SCADA DRAWINGS FOR REFERENCE.

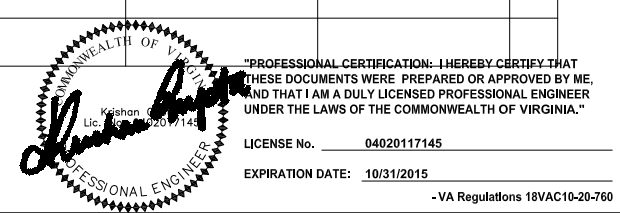

WASHINGTON METROPOLITAN AREA TRANSIT AUTHORITY DEPARTMENT OF TRANSIT INFRASTRUCTURE AND ENGINEERING SERVICES CENI - POWER SYSTEMS ENGINEERING		SIX (6) TIE BREAKER STATIONS UPGRADES ORANGE AND BLUE LINES DC, MD AND VA K06TB2 - GREENWICH ST. TIE BREAKER STATION CONDUIT AND CABLE SCHEDULE	
DESIGNED	JAJ	4/4/15	DATE
DRAWN	JAJ	5/20/15	DATE
CHECKED	PK	6/1/15	DATE
CONTRACT NO.	FQ15237	SCALE	NONE
DRAWING NO.	K06TB2-TB-300	SHEET NO.	17 OF 60

Drawing File: H:\WMATA PROJECTS\FQ15237\DRG\TBS\K06TB2 - GREENWICH ST TBS\K06TB2-TB-401.DWG
 Plotted by: E013941 Date: Fri, 30 Oct 2015 Time: 10:45:55 am
 Xrefs: N:\ROBINSON-ELECT-MECH\ELEC-MECH-PWR AutoCAD Folder\WMATA CAD TEMPLATE\Library\CUPTA SIGNATURE.tif

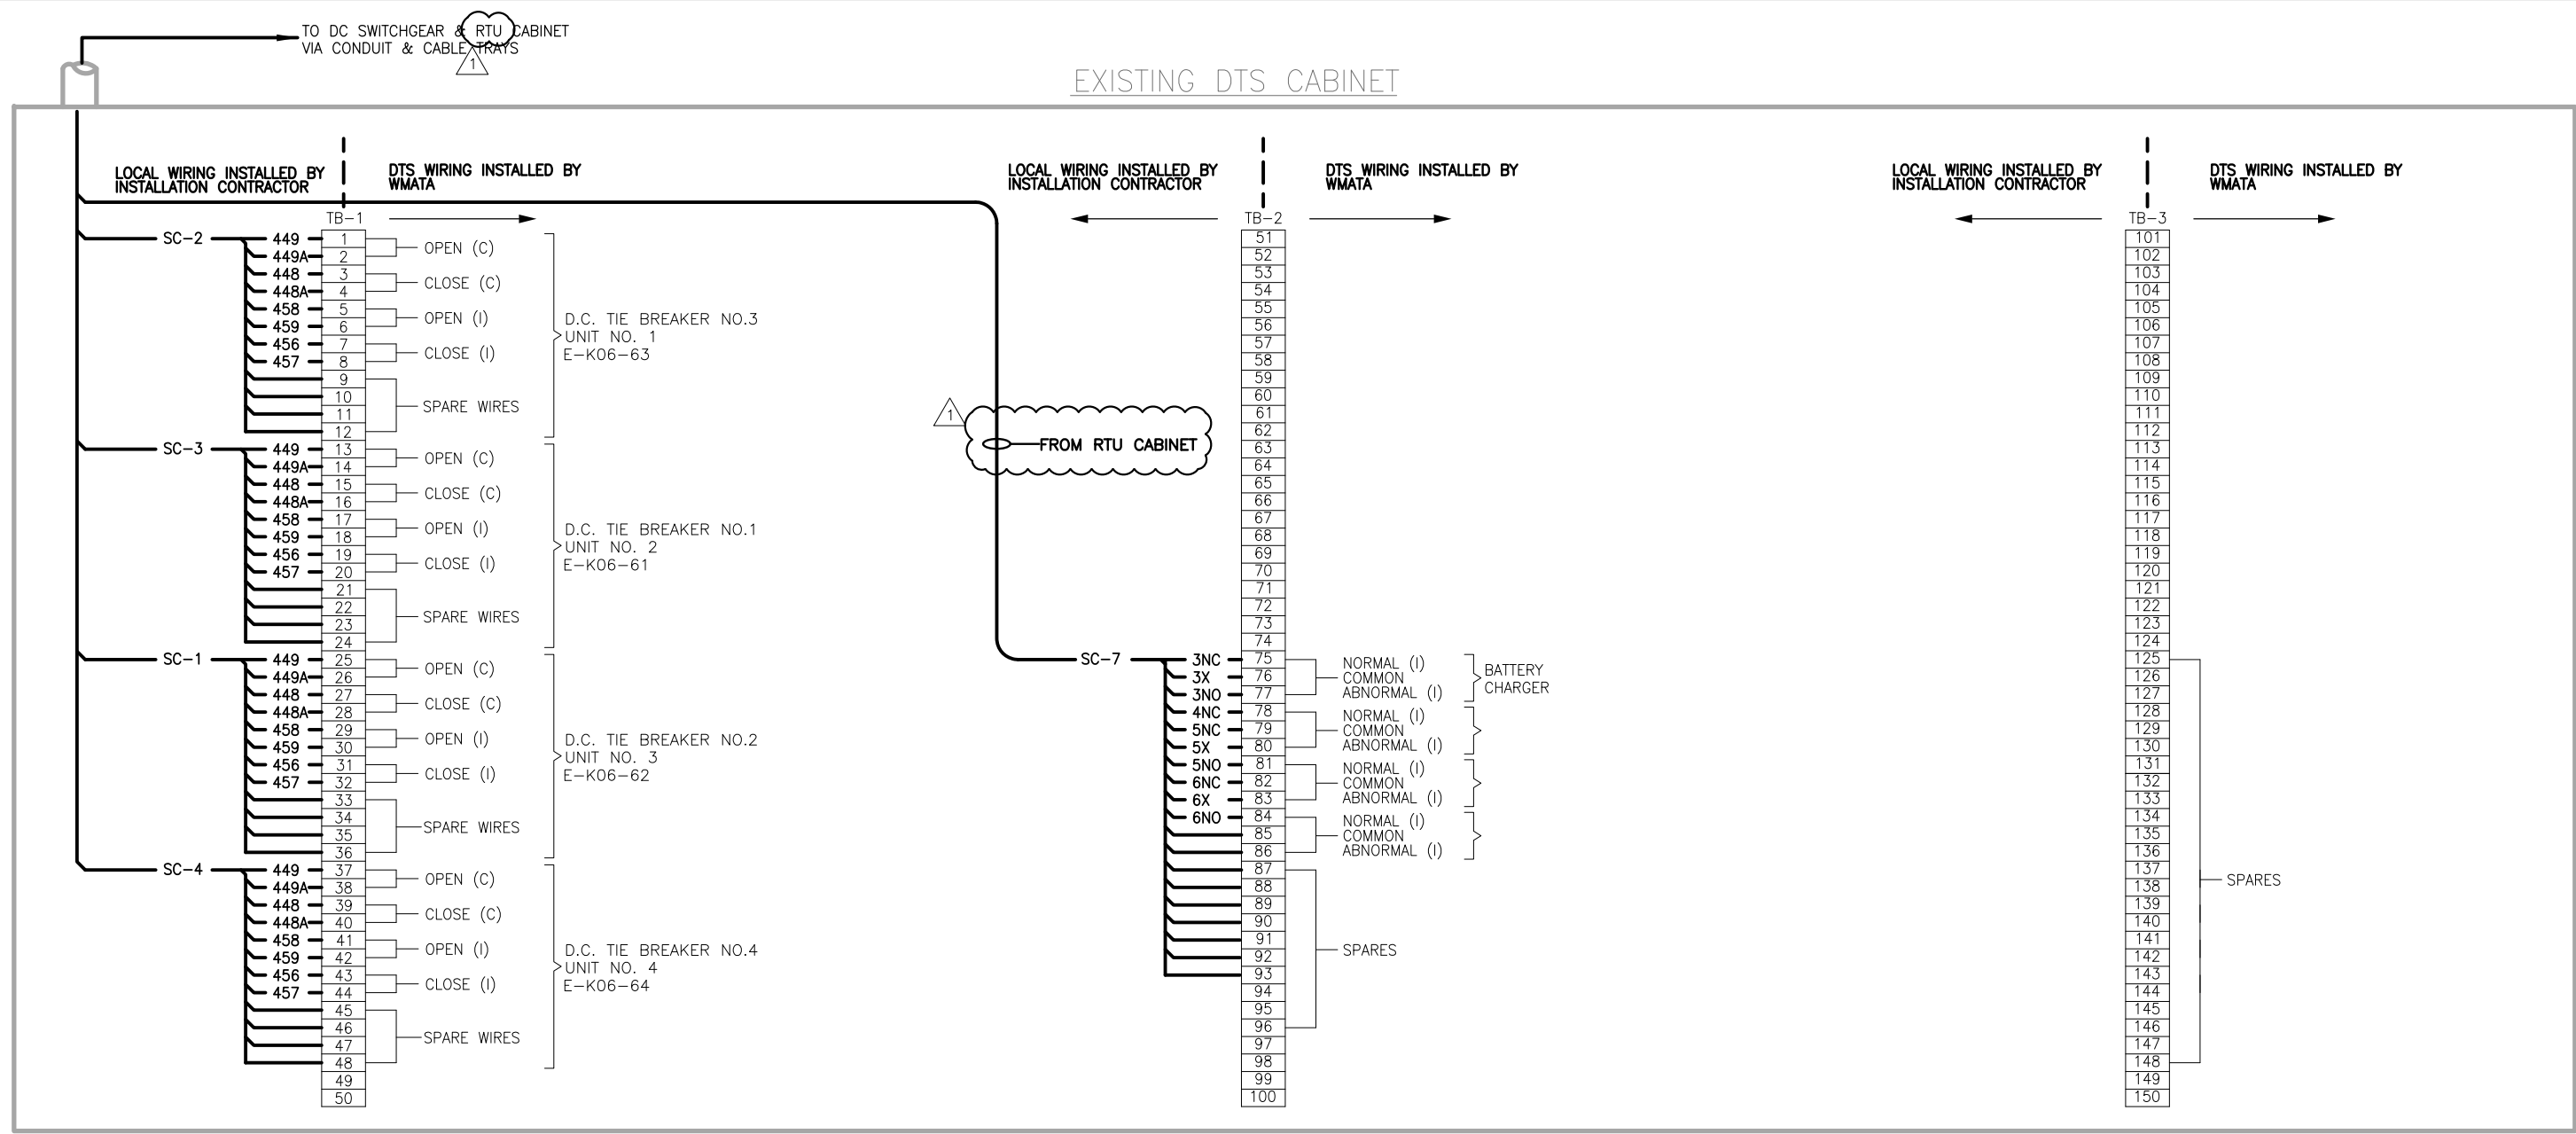

TIE BREAKER STATION

NOTES:

1. WIRING & TERMINATION FOR BATTERY CHARGER IS NOT REQUIRED WHEN D.C. POWER IS SUPPLIED FROM PASSENGER STATION. TERMINALS NOT USED WILL BECOME SPARES WITH JUMPER AT TERMINALS 76-75.
2. WHEN TWO TIE BREAKER STATIONS ARE IN THE SAME RTU CONTROL AREA, THE SECOND TIE BREAKER STATION WILL USE A DIFFERENT SERIES OF BREAKER NUMBERS. SEE TABLE AT LEFT.
3. FOR SECOND TIE BREAKER STATION, USE NUMERAL 6 INSTEAD OF 4.
4. SIX ADDITIONAL WIRES ARE BROUGHT TO DTS CABINET, THREE FOR ETS TRIP AND THREE SPARES. WMATA WILL CONNECT THEM TO TERMINAL BLOCKS AS REQUIRED.

LEGEND:

(I) — DENOTES INDICATION
 (C) — DENOTES CONTROL
 * — SEE NOTE 2

FUNCTION	BRK NO.	1 ST TBS BRK NO.	2 ND TBS BRK NO.	YARD AREA INTERFACE BRK NO.
DC TIE BRK NO.	1	41	61	81
	2	42	62	82
	3	43	63	83
	4	44	64	84
	5	45	65	85
	6	46	66	86
	7	47	67	87
	8	48	68	88



"PROFESSIONAL CERTIFICATION: I HEREBY CERTIFY THAT THESE DOCUMENTS WERE PREPARED OR APPROVED BY ME, AND THAT I AM A DULY LICENSED PROFESSIONAL ENGINEER UNDER THE LAWS OF THE COMMONWEALTH OF VIRGINIA."

LICENSE No. 04020117145
 EXPIRATION DATE: 10/31/2015

DESIGNED			DRAWN			CHECKED		
JAJ	4/4/15	DATE	JAJ	5/20/15	DATE	PK	6/1/15	DATE

REFERENCE DRAWINGS		REVISIONS	
NUMBER	TITLE	DATE	DESCRIPTION
		11/2/15	AMENDMENT NO. 1

WASHINGTON METROPOLITAN AREA TRANSIT AUTHORITY

DEPARTMENT OF TRANSIT INFRASTRUCTURE AND ENGINEERING SERVICES

CENI - POWER SYSTEMS ENGINEERING

REVISION SUBMITTED _____ DATE _____ APPROVED _____ DATE _____
 DEPUTY CHIEF ENGINEER

SIX (6) TIE BREAKER STATIONS UPGRADES ORANGE AND BLUE LINES DC, MD AND VA	
K06TB2 - GREENWICH ST. TIE BREAKER STATION SUPERVISORY AND CONTROL DIAGRAM - NEW	
CONTRACT NO. FQ15237	SCALE NONE
DRAWING NO. K06TB2-TB-401	SHEET NO. 19 OF 60

Drawing File: H:\WMATA PROJECTS\FQ15237\DRG\TBS\K07TB1-TB-300.DWG
 Plotted by: E013941 Date: Mon, 2 Nov 2015 Time: 01:57:13 pm
 Xrefs: N:\ROBINSON-ELECT-MECH\VELEC-MECH-PWR AutoCAD Folder\WMATA CAD TEMPLATE\Library\GUPTA SIGNATURE.tif ; H:\(SSE&I) - SYSTEMWIDE TIE BREAKER STATION REHAB\image0005.tif ; H:\(SSE&I)

CABLE										CIRCUIT				ROUTING				CABLE										CIRCUIT				ROUTING			
NUMBER	CONSTRUCT.	SIZE AWG.	INSULATION		VOLTAGE	A.C. OR D.C.	SPARE COND.	GROUND	FROM	VIA	TO	FOR	REV. NO.	NUMBER	CONSTRUCT.	SIZE AWG.	INSULATION		VOLTAGE	A.C. OR D.C.	SPARE COND.	GROUND	FROM	VIA	TO	FOR	REV. NO.								
			VOLTAGE	TYPE													VOLTAGE	TYPE																	
DP-1	4-1/C	1000 MCM	1000V	90°C	700V	DC	0		D.C. SWITCHGEAR UNIT NO. 1, TBKR #4	CABLE TRAY AND CONDUIT	CONTRACT RAIL O.B. END APPR. 609+4.15	TRACTION POWER FEEDER	0	AC-15	3/C	#12	600V	90°C	120 V	AC	0	1 GREEN GRD WIRE	NEW 208V/120V A.C. PNL. TB-1	CABLE TRAY AND CONDUIT	3 KVA ISOLATION TRANSFORMER. IT-1	120 VAC ISOLATED POWER	0								
DP-2	4-1/C	1000 MCM	1000V	90°C	700V	DC	0		D.C. SWITCHGEAR UNIT NO. 2, TBKR #2	CABLE TRAY AND CONDUIT	CONTRACT RAIL O.B. END APPR. 609+60.15	TRACTION POWER FEEDER	0	AC-16	2/C	#12	600V	90°C	120 V	AC	0		3 KVA ISOLATION TRANSF. IT	CABLE TRAY AND CONDUIT	DC SWITCHGEAR UNIT NO. 1	120 VAC ISOLATED POWER	0								
DP-3	4-1/C	1000 MCM	1000V	90°C	700V	DC	0		D.C. SWITCHGEAR UNIT NO. 3, TBKR #3	CABLE TRAY AND CONDUIT	CONTRACT RAIL I.B. END APPR. 609+4.15	TRACTION POWER FEEDER	0	AC-17	2/C	#12	600V	90°C	120 V	AC	0	1 GREEN GRD WIRE	NEW 208V/120V A.C. PNL. TB-1	CONDUIT	BATTERY CYCLE MONITOR	120 VAC POWER	0								
DP-4	5-1/C	1000 MCM	1000V	90°C	700V	DC	0		D.C. SWITCHGEAR UNIT NO. 4, TBKR #1	CABLE TRAY AND CONDUIT	CONTRACT RAIL I.B. END APPR. 609+60.15	TRACTION POWER FEEDER	0																						
AN-1	4/C	#14	600V	90°C	125V	D.C.	2		BATTERY CHARGER	CABLE TRAY AND CONDUIT	RTU CABINET	BATTERY CHARGER INDICATION	0	DC-1	2-1/C	#4	600V	90°C	125V	DC	0		BATTERY CHARGER	CONDUIT	NEW 200A ENCLOSED CIRCUIT BREAKER	DC POWER	0								
AN-2	NOT USED												0	DC-2	2-1/C	#3/0	600V	90°C	125V	DC	0		NEW 200A ENCLOSED CIRCUIT BREAKER	CONDUIT	BATTERY	DC POWER	0								
AN-3	NOT USED												0	DC-3	2-1/C	#3/0	600V	90°C	125V	DC	0		DC DISTRIBUTION PNL DC-10S	CABLE TRAY AND CONDUIT	NEW 200A ENCLOSED CIRCUIT BREAKER	DC POWER	0								
AN-4	NOT USED												0	DC-4	2/C	#8	600V	90°C	125V	DC	0		DC DISTRIBUTION PNL DC-10S	CABLE TRAY AND CONDUIT	D.C. SWITCHGEAR UNIT NO. 1	DC CNTRL POWER	0								
AN-5	NOT USED												0	DC-5	2/C	#12	600V	90°C	125V	DC	0		DC DISTRIBUTION PNL DC-10S	CABLE TRAY AND CONDUIT	HMI CABINET	DC POWER	0								
AN-6	12/C	#14	600V	90°C	125V	D.C.	2		EMERG. TRIP SWITCH RELAY CABINET	CABLE TRAY AND CONDUIT	RTU CABINET	ETS FAILURE INDICATION	0	DC-6	2/C	#12	600V	90°C	125V	DC	0		DC DISTRIBUTION PNL DC-10S	CABLE TRAY AND CONDUIT	D.C. CKT. BKR. TEST CABINET	DC POWER	0								
SC-1	12/C	#14	600V	90°C	24V	DC	4		DC SWITCHGEAR UNIT NO. 1	CABLE TRAY AND CONDUIT	DATA TRANSMISSION SYSTEM CABINET	CIRCUIT BREAKER CONT. & INDICATION	0	DC-8	2/C	#12	600V	90°C	125V	DC	0		DC DISTRIBUTION PNL DC-10S	CONDUIT	EMERGENCY LIGHT	DC POWER	0								
SC-2	12/C	#14	600V	90°C	24V	DC	4		DC SWITCHGEAR UNIT NO. 2	CABLE TRAY AND CONDUIT	DATA TRANSMISSION SYSTEM CABINET	CIRCUIT BREAKER CONT. & INDICATION	0	DC-9	2/C	#12	600V	90°C	125V	DC	0		DC DISTRIBUTION PNL DC-10S	CABLE TRAY AND CONDUIT	RTU	DC POWER	0								
SC-3	12/C	#14	600V	90°C	24V	DC	4		DC SWITCHGEAR UNIT NO. 3	CABLE TRAY AND CONDUIT	DATA TRANSMISSION SYSTEM CABINET	CIRCUIT BREAKER CONT. & INDICATION	0	DC-10	2/C	#12	600V	90°C	125V	DC	0		DC DISTRIBUTION PNL DC-10S	CABLE TRAY AND CONDUIT	NEW NETWORK SWITCH	DC POWER	0								
SC-4	12/C	#14	600V	90°C	24V	DC	4		DC SWITCHGEAR UNIT NO. 4	CABLE TRAY AND CONDUIT	DATA TRANSMISSION SYSTEM CABINET	CIRCUIT BREAKER CONT. & INDICATION	0																						
SC-7	19/C	#14	600V	90°C	24V	DC	1		RTU CABINET	CABLE TRAY AND CONDUIT	DTS CABINET	ANNUNCIATION	0																						
AC-1	4/C	#10	600V	90°C	480 V	AC	0	1 GREEN GRD WIRE	VOLTAGE REGULATOR	CONDUIT	NEW 480/277 VAC PANEL TB	480 VAC POWER	0	ET-1	4/C	#10	600V	90°C	125V	DC	2		EMERGENCY TRIP SWITCH RELAY CABINET	CABLE TRAY AND CONDUIT	DC SWITCHGEAR UNIT NO. 1	CONTACT RAIL EMERGENCY TRIP	0								
AC-2	3/C	#10	600V	90°C	480 V	AC	0	1 GREEN GRD WIRE	NEW 480/277 VAC PANEL TB	CONDUIT	15 KVA TRANSFORMER	TRANSFORMER POWER	0	ET-2	4/C	#10	600V	90°C	125V	DC	2		EMERGENCY TRIP SWITCH RELAY CABINET	CABLE TRAY AND CONDUIT	DC SWITCHGEAR UNIT NO. 2	CONTACT RAIL EMERGENCY TRIP	0								
AC-3	3/C	#10	600V	90°C	480 V	AC	0	1 GREEN GRD WIRE	NEW 480/277 VAC PANEL TB	CONDUIT	UNIT HEATER #1	480 VAC POWER TO UNIT HEATER	0	ET-3	4/C	#10	600V	90°C	125V	DC	2		EMERGENCY TRIP SWITCH RELAY CABINET	CABLE TRAY AND CONDUIT	DC SWITCHGEAR UNIT NO. 3	CONTACT RAIL EMERGENCY TRIP	0								
AC-4	3/C	#10	600V	90°C	480 V	AC	0	1 GREEN GRD WIRE	NEW 480/277 VAC PANEL TB	CONDUIT	UNIT HEATER #2	480 VAC POWER TO UNIT HEATER	0	ET-4	4/C	#10	600V	90°C	125V	DC	2		EMERGENCY TRIP SWITCH RELAY CABINET	CABLE TRAY AND CONDUIT	DC SWITCHGEAR UNIT NO. 4	CONTACT RAIL EMERGENCY TRIP	0								
AC-5	2/C	#12	600V	90°C	277 V	AC	0	1 GREEN GRD WIRE	NEW 480/277 VAC PANEL TB	CONDUIT	TBS INDOOR LIGHTS	TBS LIGHTS A.C. FEED	0																						
AC-6	2/C	#12	600V	90°C	277 V	AC	0	1 GREEN GRD WIRE	NEW 480/277 VAC PANEL TB	CONDUIT	TBS OUTDOOR LIGHTS	TBS LIGHTS A.C. FEED	0																						
AC-7	4/C	#12	600V	90°C	480 V	AC	0	1 GREEN GRD WIRE	NEW 480/277 VAC PANEL TB	CONDUIT	BATTERY CHARGER	480 VAC POWER TO BATT. CHARGER	0	MA-1	1/C	#6	2000V	90°C	GND		0		DC SWITCHGEAR UNIT NO. 1	CONDUIT	STATION GROUND	LIGHTNING ARRESTER GND.	0								
AC-8	4/C	#12	600V	90°C	208 V	AC	0	1 GREEN GRD WIRE	NEW 15 KVA TRANSFORMER	CABLE TRAY AND CONDUIT	NEW 208V/120V A.C. PANEL TB-1	208/120 VAC POWER	0	MA-2	1/C	#6	2000V	90°C	GND		0		DC SWITCHGEAR UNIT NO. 2	CONDUIT	STATION GROUND	LIGHTNING ARRESTER GND.	0								
AC-9	2/C	#12	600V	90°C	120 V	AC	0	1 GREEN GRD WIRE	NEW 208V/120V A.C. PANEL TB-1	CONDUIT	EXHAUST FAN #1	120 VAC POWER	0	MA-3	1/C	#6	2000V	90°C	GND		0		DC SWITCHGEAR UNIT NO. 3	CONDUIT	STATION GROUND	LIGHTNING ARRESTER GND.	0								
AC-10	2/C	#12	600V	90°C	120 V	AC	0	1 GREEN GRD WIRE	NEW 208V/120V A.C. PANEL TB-1	CONDUIT	EXHAUST FAN #2	120 VAC POWER	0	MA-4	1/C	#6	2000V	90°C	GND		0		DC SWITCHGEAR UNIT NO. 4	CONDUIT	STATION GROUND	LIGHTNING ARRESTER GND.	0								
AC-11	2/C	#12	600V	90°C	120 V	AC	0	1 GREEN GRD WIRE	NEW 208V/120V A.C. PANEL TB-1	CONDUIT	RTU	120 VAC POWER	0	MA-5	NOT USED																				
AC-12	2/C	#10	600V	90°C	120 V	AC	0	1 GREEN GRD WIRE	NEW 208V/120V A.C. PANEL TB-1	CONDUIT	RECEPTACLES	120 VAC POWER	0	MA-6	2/C	#10	600V	90°C	GRD		0		DC SWITCHGEAR UNIT NO. 1	CABLE TRAY AND CONDUIT	STATION GROUND	GROUND RELAY	0								
AC-13	2/C	#10	600V	90°C	120 V	AC	0	1 GREEN GRD WIRE	NEW 208V/120V A.C. PANEL TB-1	CONDUIT	ROLL-UP DOOR	120 VAC POWER	0	MA-7	1/C	#10	1000V	90°C	700V		1		DC SWITCHGEAR UNIT NO. 1	CONDUIT	NEGATIVE POLARITY J-BOX	NEG. POLARITY REFERENCE O.B.	0								
AC-14	2/C	#10	600V	90°C	120 V	AC	0	1 GREEN GRD WIRE	NEW 208V/120V A.C. PANEL TB-1	CONDUIT	OUTDOOR LIGHT	120 VAC POWER	0	MA-8	1/C	#10	1000V	90°C	700V		1		DC SWITCHGEAR UNIT NO. 4	CONDUIT	NEGATIVE POLARITY J-BOX	NEG. POLARITY REFERENCE O.B.	0								

H - A.C. PRIMARY VOLTAGE CABLE
 DP - D.C. POSITIVE POWER CABLE
 DN - D.C. NEGATIVE POWER CABLE
 DD - D.C. UTILITY DRAIN CABLE
 AN - ANNUNCIATOR CABLE
 SC - SUPERVISORY CONTROL CABLE
 ET - EMERGENCY TRIP CABLE
 MT - METERING & INSTRUMENTATION CABLE
 CN - OPERATING CONTROL CABLE
 MA - MISCELLANEOUS CIRCUITS
 AC - A.C. LOW VOLTAGE POWER CIRCUITS
 DC - D.C. CONTROL POWER CIRCUITS

END APPR - END APPROACH OF CONTACT RAIL
BOLD TEXT INDICATES NEW CABLES
 SCREENED TEXT INDICATES EXISTING TO REMAIN CABLES

NOTE:
 CABLES AN-1, AN-6, SC-7, AC-11, AC-17, DC-5, DC-9 AND DC-10 ARE SHOWN ON SCADA DRAWING ALSO FOR REFERENCE

PROFESSIONAL ENGINEER
 License No. 04020117145
 EXPIRATION DATE: 10/31/2015
 -VA Regulations 18VAC10-20-760

DESIGNED			DRAWN			CHECKED		
JAJ	4/4/15	DATE	JAJ	5/20/15	DATE	PK	6/1/15	DATE

REFERENCE DRAWINGS		REVISIONS	
NUMBER	TITLE	DATE	DESCRIPTION
		11/2/15	AMENDMENT NO. 1


WASHINGTON METROPOLITAN AREA TRANSIT AUTHORITY
DEPARTMENT OF TRANSIT INFRASTRUCTURE AND ENGINEERING SERVICES
CENI - POWER SYSTEMS ENGINEERING

REVISION SUBMITTED _____ DATE _____
 APPROVED _____ DATE _____
 DEPUTY CHIEF ENGINEER


SIX (6) TIE BREAKER STATIONS UPGRADES ORANGE AND BLUE LINES DC, MD AND VA
K07TB1 - OGDEN ST. TIE BREAKER STATION CONDUIT AND CABLE SCHEDULE

CONTRACT NO. FQ15237	SCALE NONE	DRAWING NO. K07TB1-TB-300	SHEET NO. 25 OF 60
-------------------------	---------------	------------------------------	-----------------------


Drawing File: H:\WMATA PROJECTS\FQ15237\DRG\TBS\K06TB2 - GREENWICH ST TBS\K06TB2-TB-500.DWG
 Plotted by: E013941 Date: Fri, 30 Oct 2015 Time: 11:58:43 am
 Xrefs: N:\ROBINSON-ELECT-MECH\ELEC-MECH-PWR AutoCAD Folder\WMATA CAD TEMPLATE\Library\CUIPTA SIGNATURE.tif

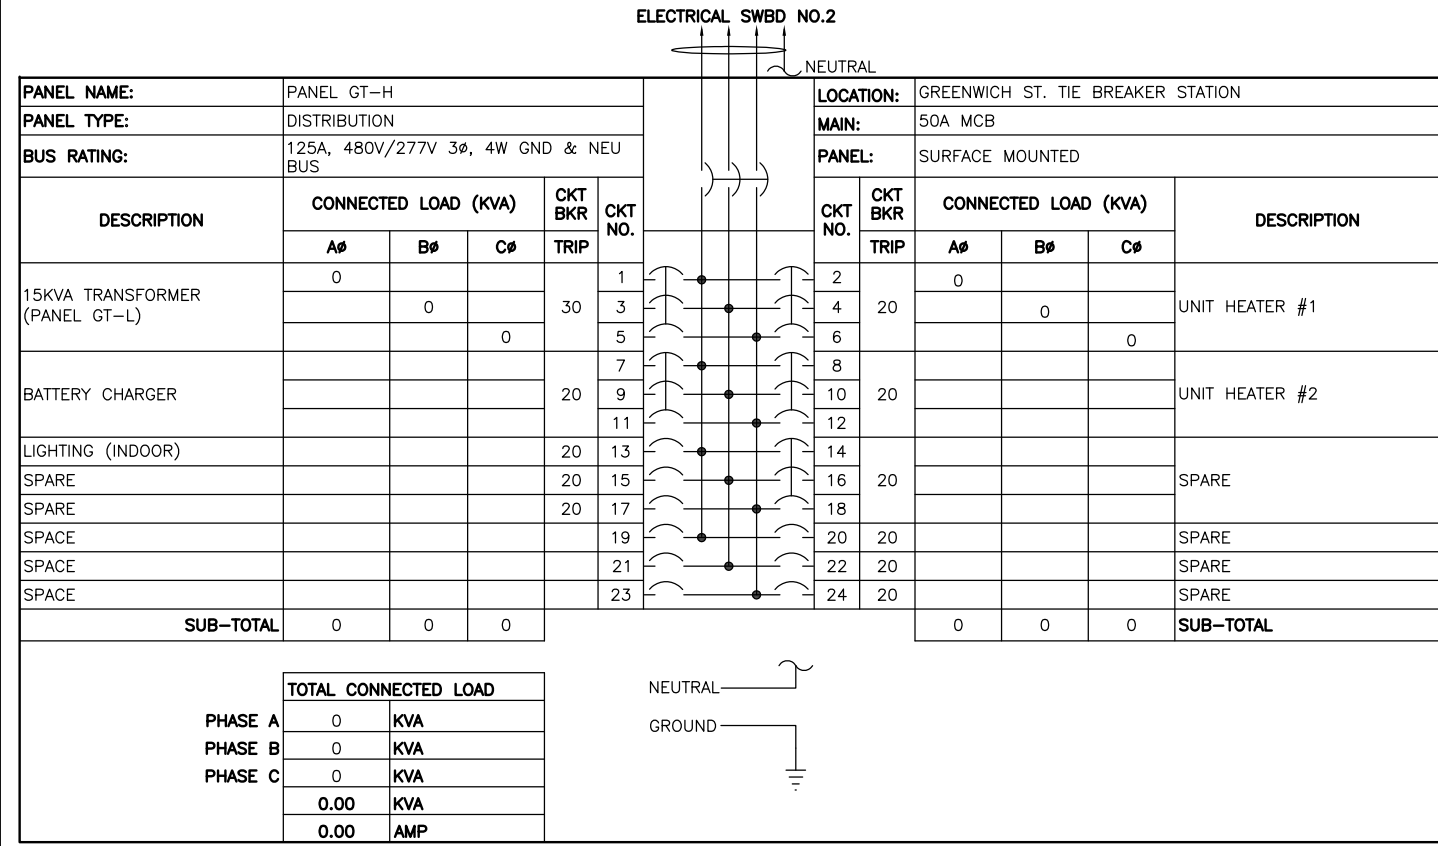


TOTAL CONNECTED LOAD	
PHASE A	0 KVA
PHASE B	0 KVA
PHASE C	0 KVA
	0.00 KVA
	0.00 AMP

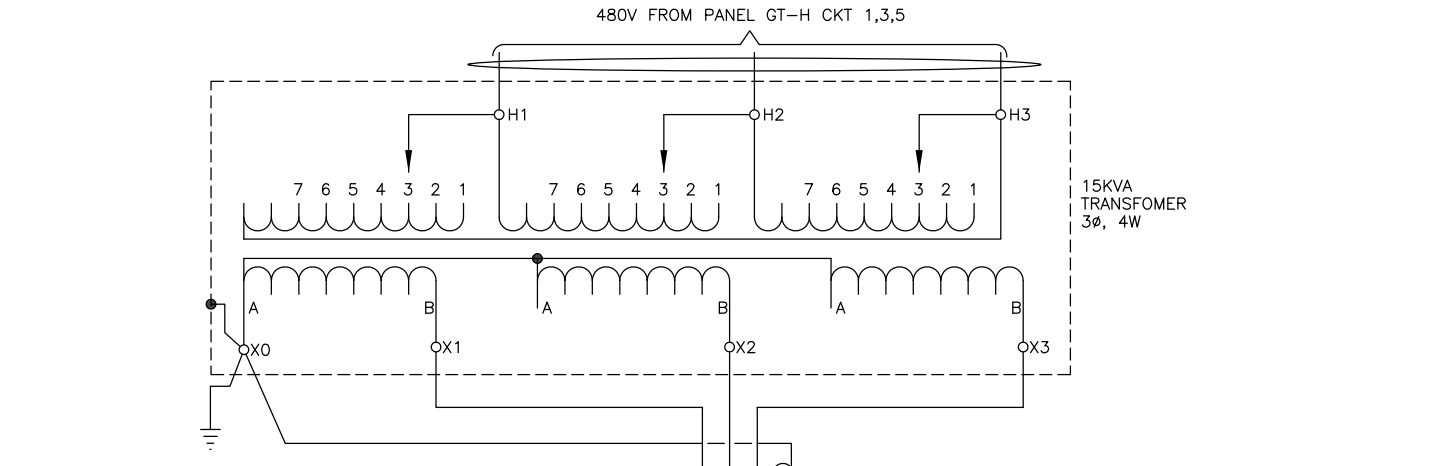

TOTAL CONNECTED LOAD	
PHASE A	0 KVA
PHASE B	0 KVA
PHASE C	0 KVA
	0.00 KVA
	0.00 AMP

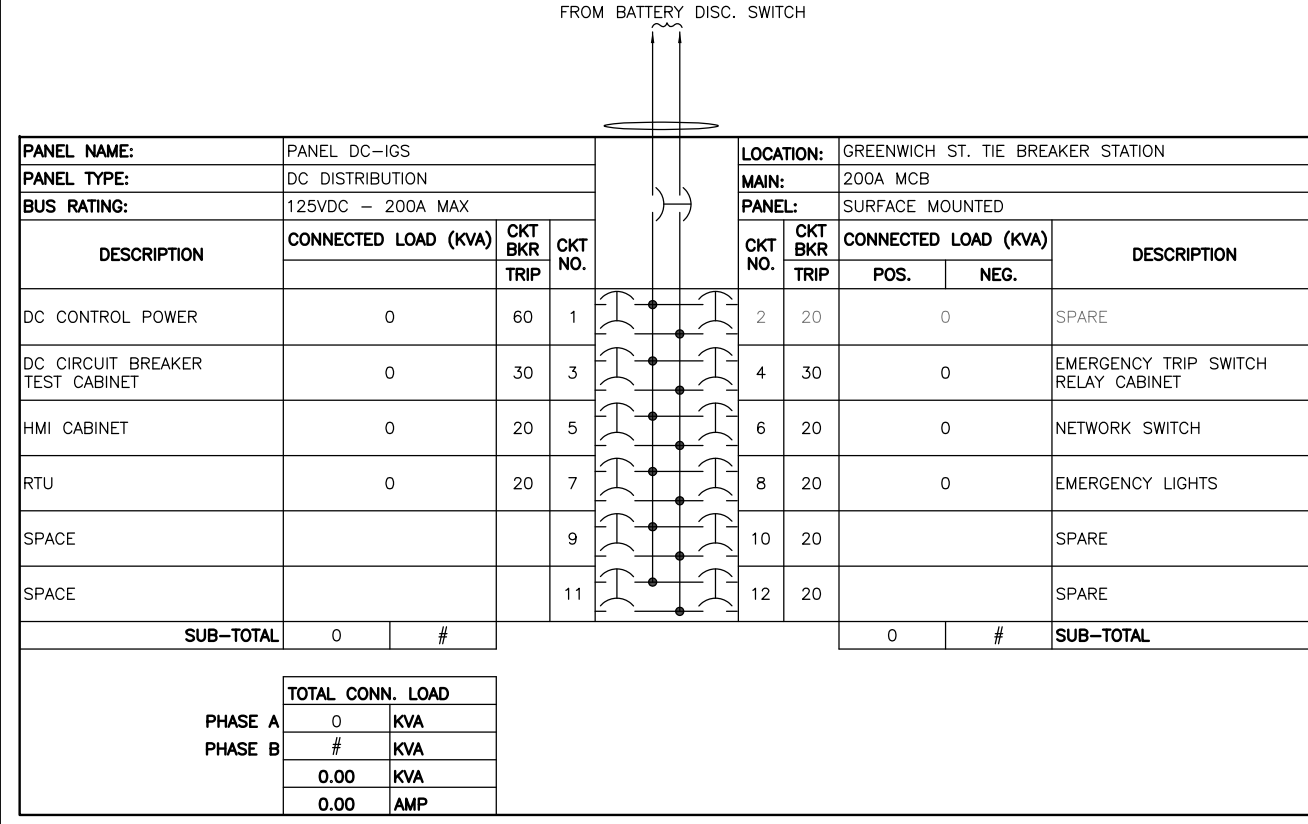

TOTAL CONN. LOAD	
PHASE A	0 KVA
PHASE B	# KVA
	0.00 KVA
	0.00 AMP

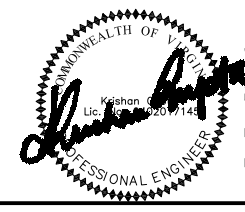

"PROFESSIONAL CERTIFICATION: I HEREBY CERTIFY THAT THESE DOCUMENTS WERE PREPARED OR APPROVED BY ME, AND THAT I AM A DULY LICENSED PROFESSIONAL ENGINEER UNDER THE LAWS OF THE COMMONWEALTH OF VIRGINIA."
 LICENSE No. 04020117145
 EXPIRATION DATE: 10/31/2015

REFERENCE DRAWINGS			REVISIONS		
DESIGNED	DATE	TITLE	DATE	NUM	DESCRIPTION
JAJ	4/4/15		11/2/15	Δ	AMENDMENT NO. 1
JAJ	5/20/15				
PK	6/1/15				

WASHINGTON METROPOLITAN AREA TRANSIT AUTHORITY
DEPARTMENT OF TRANSIT INFRASTRUCTURE AND ENGINEERING SERVICES
CENI - POWER SYSTEMS ENGINEERING


REVISION SUBMITTED: _____ DATE: _____
 APPROVED: _____ DATE: _____
 DEPUTY CHIEF ENGINEER

SIX (6) TIE BREAKER STATIONS UPGRADES
ORANGE AND BLUE LINES DC, MD AND VA
K06TB2 - GREENWICH ST. TIE BREAKER STATION
PANELBOARD SCHEDULES

CONTRACT NO. FQ15237	SCALE NONE	DRAWING NO. K06TB2-TB-500	SHEET NO. 20 OF 60
-------------------------	---------------	------------------------------	-----------------------

-VA Regulations 18VAC10-20-760

Drawing File: H:\WMATA PROJECTS\FQ15237\DRG\TBS\K07TB1 - TB-401.DWG
 Plotted by: E013941 Date: Fri, 30 Oct 2015 Time: 10:46:25 am
 Xrefs: N:\ROBINSON-ELECT-MECH\ELEC-MECH-PWR AutoCAD Folder\WMATA CAD TEMPLATE\Library\CUPTA SIGNATURE.tif

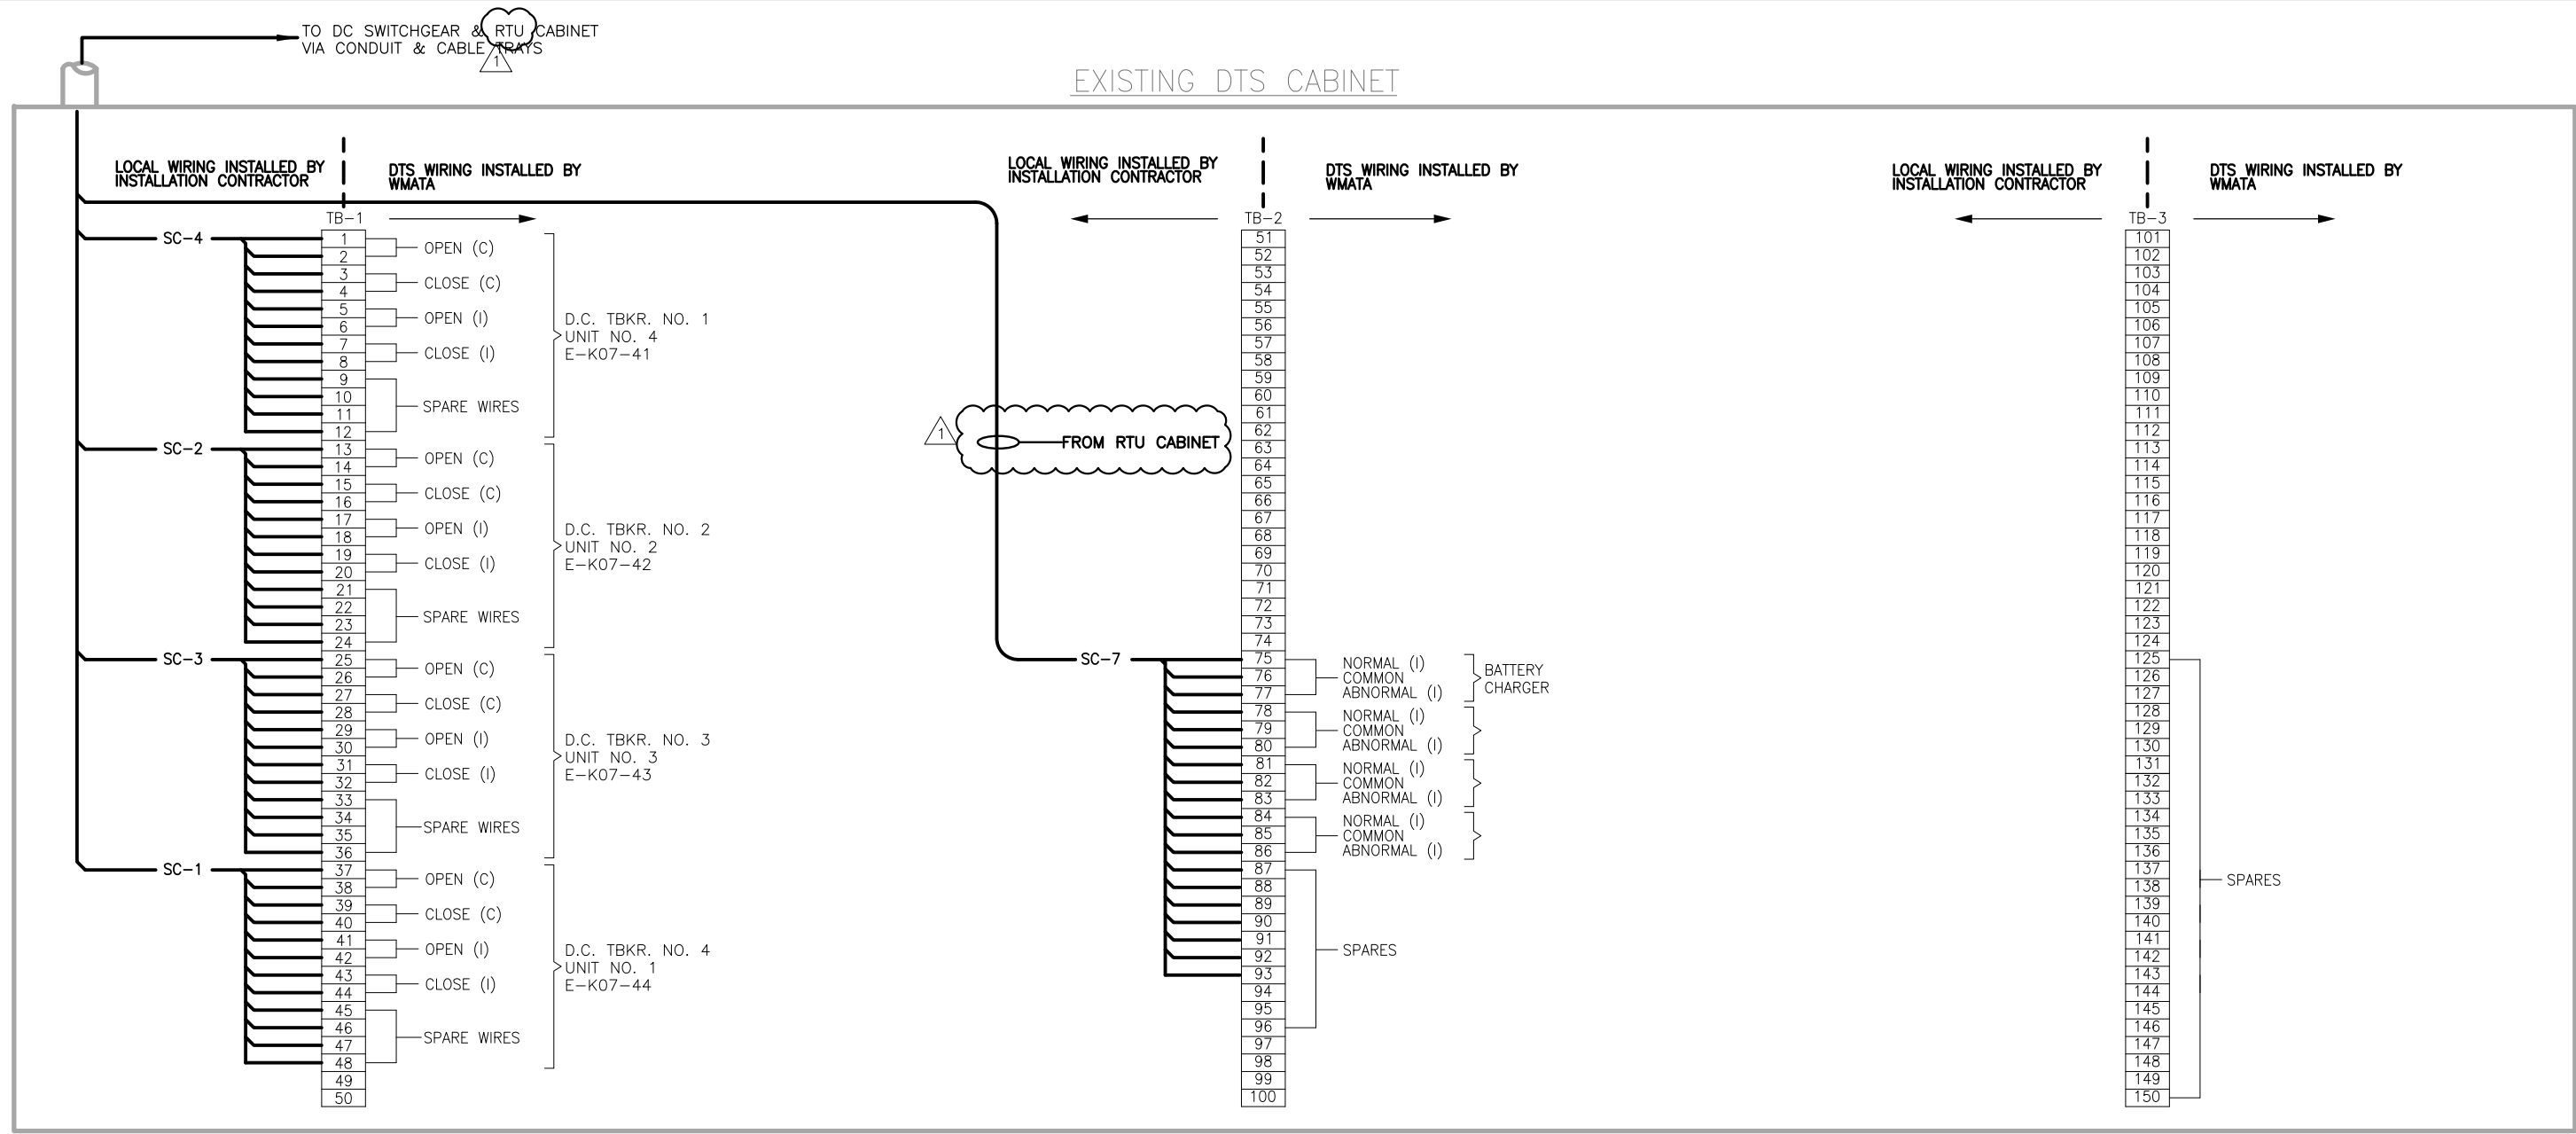

TIE BREAKER STATION

NOTES:

1. WIRING & TERMINATION FOR BATTERY CHARGER IS NOT REQUIRED WHEN D.C. POWER IS SUPPLIED FROM PASSENGER STATION. TERMINALS NOT USED WILL BECOME SPARES WITH JUMPER AT TERMINALS 76-75.
2. WHEN TWO TIE BREAKER STATIONS ARE IN THE SAME RTU CONTROL AREA, THE SECOND TIE BREAKER STATION WILL USE A DIFFERENT SERIES OF BREAKER NUMBERS. SEE TABLE AT LEFT.
3. FOR SECOND TIE BREAKER STATION, USE NUMERAL 6 INSTEAD OF 4.
4. SIX ADDITIONAL WIRES ARE BROUGHT TO DTS CABINET, THREE FOR ETS TRIP AND THREE SPARES. WMATA WILL CONNECT THEM TO TERMINAL BLOCKS AS REQUIRED.


LEGEND:
 (I) — DENOTES INDICATION
 (C) — DENOTES CONTROL
 * — SEE NOTE 2

FUNCTION	BRK NO.	1 ST TBS BRK NO.	2 ND TBS BRK NO.	YARD AREA INTERFACE BRK NO.
DC TIE BRK NO.	1	41	61	81
	2	42	62	82
	3	43	63	83
	4	44	64	84
	5	45	65	85
	6	46	66	86
	7	47	67	87
	8	48	68	88

"PROFESSIONAL CERTIFICATION: I HEREBY CERTIFY THAT THESE DOCUMENTS WERE PREPARED OR APPROVED BY ME, AND THAT I AM A DULY LICENSED PROFESSIONAL ENGINEER UNDER THE LAWS OF THE COMMONWEALTH OF VIRGINIA."
 LICENSE No. 04020117145
 EXPIRATION DATE: 10/31/2015
- VA Regulations 18VAC10-20-760

DESIGNED: JAJ 4/4/15 DRAWN: JAJ 5/20/15 CHECKED: PK 6/1/15	REFERENCE DRAWINGS NUMBER TITLE DATE NUM DESCRIPTION 11/2/15 Δ AMENDMENT NO. 1	REVISIONS DATE NUM DESCRIPTION 11/2/15 Δ AMENDMENT NO. 1	 WASHINGTON METROPOLITAN AREA TRANSIT AUTHORITY DEPARTMENT OF TRANSIT INFRASTRUCTURE AND ENGINEERING SERVICES CENI - POWER SYSTEMS ENGINEERING	SIX (6) TIE BREAKER STATIONS UPGRADES ORANGE AND BLUE LINES DC, MD AND VA K07TB1 - OGDEN ST. TIE BREAKER STATION SUPERVISORY AND CONTROL DIAGRAM - NEW
			REVISION SUBMITTED DATE APPROVED DATE DEPUTY CHIEF ENGINEER	CONTRACT NO. FQ15237 SCALE NONE DRAWING NO. K07TB1-TB-401 SHEET NO. 27 OF 60

Drawing File: H:\WMATA\PROJECTS\FQ15237\DRG\TBS\K07TB2 - PROSPERITY AVE TBS\K07TB2-TB-200.DWG
 Plotted by: E013941 Date: Fri, 30 Oct 2015 Time: 10:46:31 am
 Xrefs: .\..\..\DES\ARCH\K07TB2 - PROSPERITY AVENUE TBS FLOOR PLAN.dwg ; .\..\..\DES\TBS\K07TB2 - PROSPERITY AVENUE TBS DESIGN FILE.dwg
 Images: .\N:\ROBINSON-ELECT-MECH\ELEC-MECH-PWR AutoCAD Folder\WMATA CAD TEMPLATE\Library\GUPTA SIGNATURE.tif

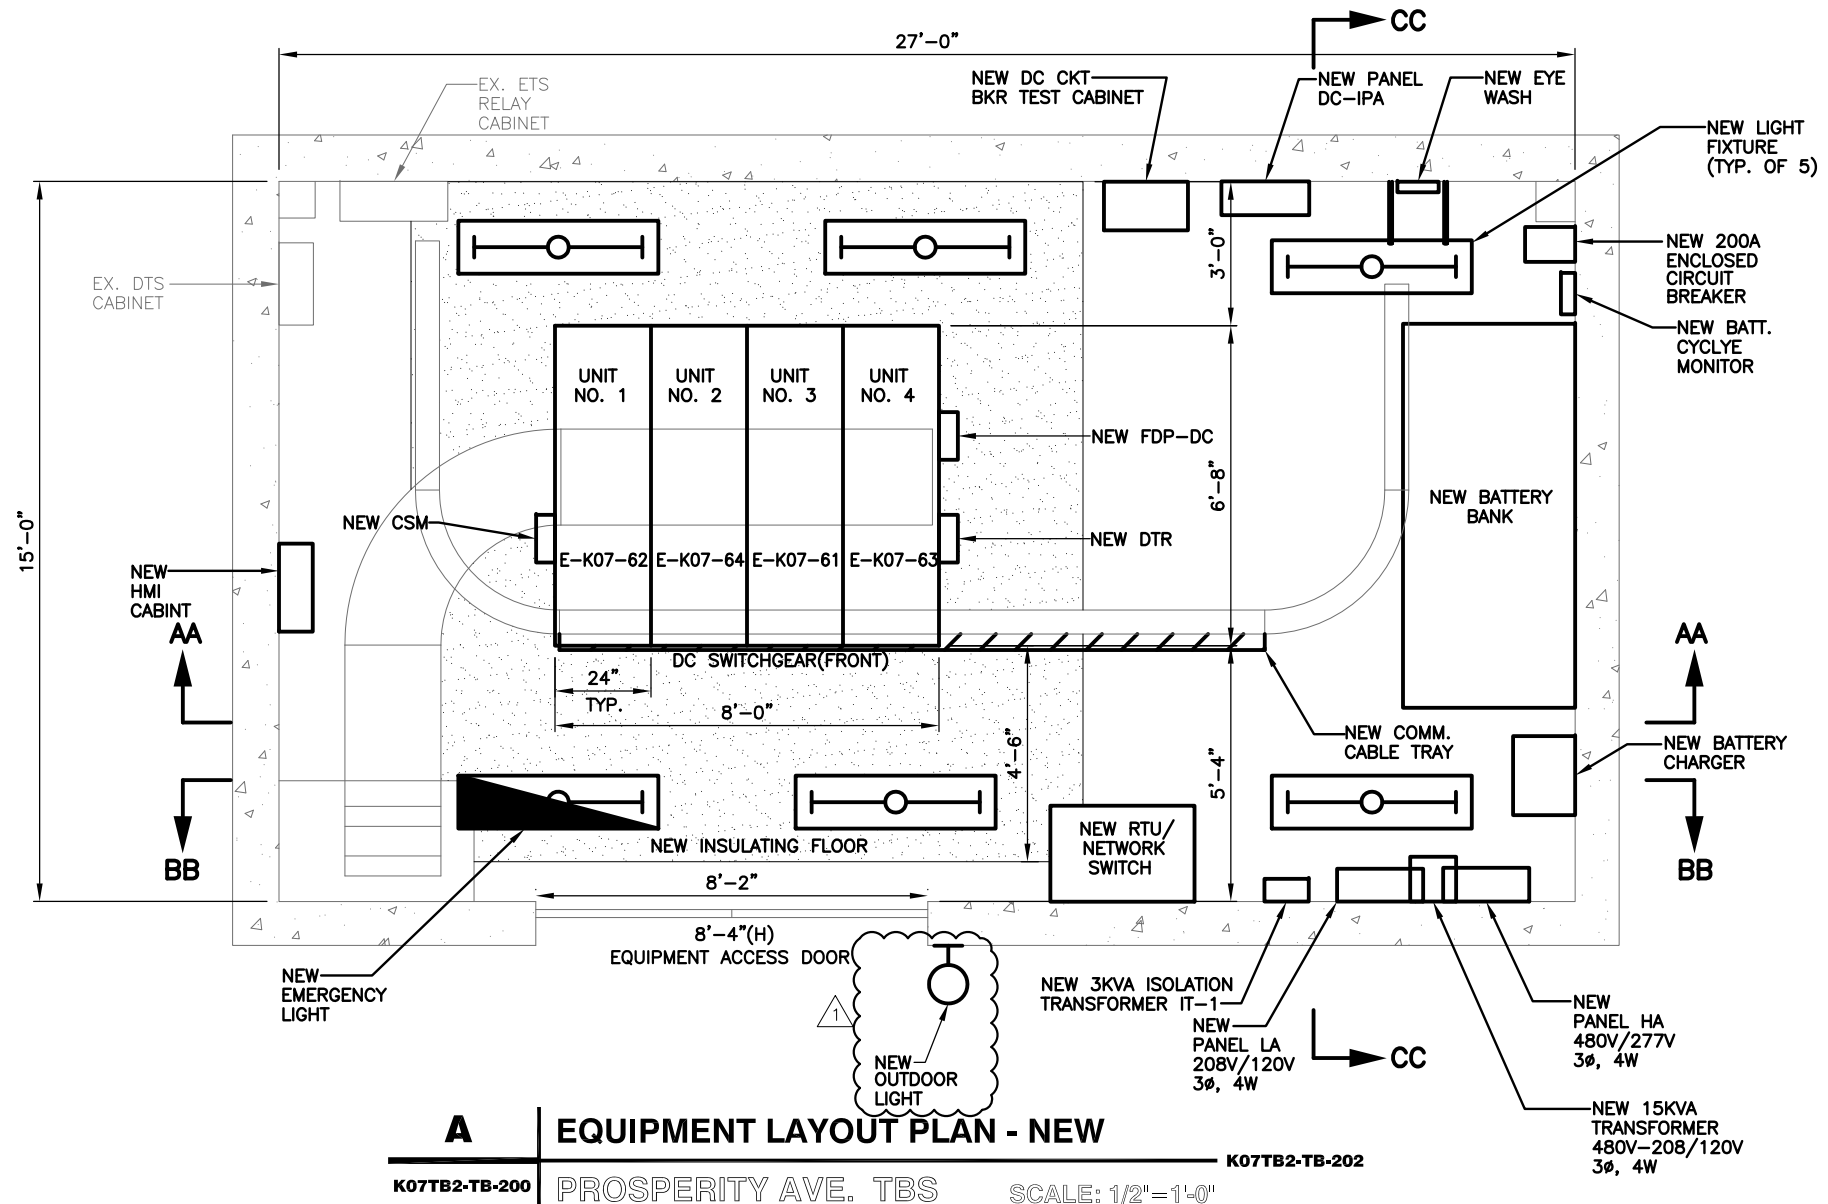

A | **EQUIPMENT LAYOUT PLAN - NEW**
 K07TB2-TB-200 | PROSPERITY AVE. TBS | SCALE: 1/2"=1'-0"
 K07TB2-TB-202

DESCRIPTION OF MAJOR WORK

1. REMOVE EXISTING DC SWITCHGEAR AND PROVIDE AND INSTALL NEW DC SWITCHGEAR.
2. REMOVE EXISTING BATTERY BANK AND PROVIDE AND INSTALL NEW BATTERY BANK.
3. PROVIDE AND INSTALL A NEW 3KVA ISOLATION TRANSFORMER IT1 WITH PANEL.
4. REMOVE EXISTING DC CIRCUIT BREAKER TEST CABINET AND PROVIDE AND INSTALL NEW DC CIRCUIT BREAKER TEST CABINET.
5. REMOVE EXISTING DC DISTRIBUTION PANEL AND PROVIDE AND INSTALL NEW DC DISTRIBUTION PANEL DC-IPA.
6. REMOVE EXISTING LIGHT FIXTURES AND PROVIDE AND INSTALL NEW LIGHT FIXTURES AND PROVIDE AND INSTALL NEW EMERGENCY LIGHT FIXTURE. SEE GENERAL NOTES FOR WIRING INFORMATION.
7. REMOVE EXISTING 15KVA TRANSFORMER AND PROVIDE AND INSTALL NEW 15KVA, 480V-208V/120V TRANSFORMER
8. REMOVE EXISTING PANEL HA AND PROVIDE AND INSTALL NEW 480V/277V, 3φ, 4W AC PANEL HA.
9. REMOVE EXISTING PANEL LA AND PROVIDE AND INSTALL NEW 208V/120V, 3φ, 4W AC PANEL LA.
10. REMOVE EXISTING EMERG. PANEL EAC-IPA.
11. REMOVE EXISTING DC TO AC INVERTER.
12. REMOVE EXISTING ANNUNCIATOR PANEL AND ALL ASSOCIATED CABLING.
13. REMOVE EXISTING EYE WASH AND PROVIDE AND INSTALL NEW EYE WASH EQUIPMENT.
14. REMOVE EXISTING INSULATING FLOOR AND PROVIDE AND INSTALL NEW INSULATING FLOOR.
15. REMOVE EXISTING BATTERY CHARGER AND PROVIDE AND INSTALL NEW BATTERY CHARGER.
16. CONTRACTOR SHALL PROVIDE AND INSTALL NEW BATTERY CYCLE MONITOR.
17. CONTRACTOR SHALL PROVIDE AND INSTALL NEW 200A ENCLOSED CIRCUIT BREAKER.

DESCRIPTION OF SCADA WORK:

1. PROVIDE AND INSTALL NEW HMI CABINET.
2. PROVIDE AND INSTALL NEW CABLE SHIELD MONITOR(CSM).
3. PROVIDE AND INSTALL NEW RTU/NETWORK SWITCH CABINET.
4. PROVIDE AND INSTALL NEW DIGITAL TRACE RECORDER (DTR).
5. PROVIDE AND INSTALL NEW FIBER DISTRIBUTION PANEL FOR DC SWITCHGEAR (FDP-DC).
6. PROVIDE AND INSTALL A 8 INCH WIDE MINIMUM WIRE-MESH TYPE COMMUNICATION CABLE TRAY, ALONG WITH SUPPORTS, GROUNDING, ISOLATION AND FITTING REQUIREMENTS AS PER THE MANUFACTURER'S RECOMMENDATION, IN COMPLIANT WITH NEC'S FILL CRITERIA AND WMATA'S SPECIFICATION.



"PROFESSIONAL CERTIFICATION: I HEREBY CERTIFY THAT THESE DOCUMENTS WERE PREPARED OR APPROVED BY ME, AND THAT I AM A DULY LICENSED PROFESSIONAL ENGINEER UNDER THE LAWS OF THE COMMONWEALTH OF VIRGINIA."
 LICENSE No. 04020117145
 EXPIRATION DATE: 10/31/2015
 -VA Regulations 18VAC10-20-760

DESIGNED JAJ 4/4/15 DATE DRAWN JAJ 5/20/15 DATE CHECKED PK 6/1/15 DATE			<table border="1"> <thead> <tr> <th colspan="2">REFERENCE DRAWINGS</th> <th colspan="2">REVISIONS</th> </tr> <tr> <th>NUMBER</th> <th>TITLE</th> <th>DATE</th> <th>DESCRIPTION</th> </tr> </thead> <tbody> <tr> <td></td> <td></td> <td>11/2/15</td> <td>AMENDMENT NO. 1</td> </tr> </tbody> </table>			REFERENCE DRAWINGS		REVISIONS		NUMBER	TITLE	DATE	DESCRIPTION			11/2/15	AMENDMENT NO. 1	WASHINGTON METROPOLITAN AREA TRANSIT AUTHORITY DEPARTMENT OF TRANSIT INFRASTRUCTURE AND ENGINEERING SERVICES CENI - POWER SYSTEMS ENGINEERING			SIX (6) TIE BREAKER STATIONS UPGRADES ORANGE AND BLUE LINES DC, MD AND VA K07TB2 - PROSPERITY AVE. TIE BREAKER STATION EQUIPMENT LAYOUT PLAN - NEW		
REFERENCE DRAWINGS		REVISIONS																					
NUMBER	TITLE	DATE	DESCRIPTION																				
		11/2/15	AMENDMENT NO. 1																				
REVISION SUBMITTED _____ DATE _____ APPROVED _____ DATE _____ DEPUTY CHIEF ENGINEER			CONTRACT NO. FQ15237 SCALE AS NOTED DRAWING NO. K07TB2-TB-200 SHEET NO. 30 OF 60																				


Drawing File: H:\WMATA PROJECTS\F015237\DRG\TBS\K07TB2 - TB-300.DWG
 Plotted by: E013941 Date: Fri, 30 Oct 2015 Time: 10:46:40 am
 Xrefs: N:\ROBINSON-ELECT-MECH\VELEC-MECH-PWR AutoCAD Folder\WMATA CAD TEMPLATE\Library\CAD\Signature.tif

CABLE										CIRCUIT				ROUTING				CABLE										CIRCUIT				ROUTING			
NUMBER	CONSTRUCT.	SIZE AWG.	INSULATION		VOLTAGE	A.C. OR D.C.	SPARE COND.	GRD COND.	SIZE	FROM	VIA	TO	FOR	REV. NO.	NUMBER	CONSTRUCT.	SIZE AWG.	INSULATION		VOLTAGE	A.C. OR D.C.	SPARE COND.	FROM	VIA	TO	FOR	REV. NO.								
			VOLTAGE	TYPE														VOLTAGE	TYPE																
DP-1	4-1/C	1000 MCM	1000V	90°C	700V	DC	0		DC SWITCHGEAR UNIT NO.1 BKR. #62	CABLE TRAY & CONDUIT	CONTACT RAIL O.B. END APPR. 677+65.35	TRACTION POWER FEEDER	0	DC-1	2-1/C	#4	600V	90°C	125V	DC	0	BATTERY CHARGER	CONDUIT	NEW 200A ENCLOSED CIRCUIT BREAKER	BATTERY CHARGING DC FEED	0									
DP-2	4-1/C	1000 MCM	1000V	90°C	700V	DC	0		DC SWITCHGEAR UNIT NO.2 BKR. #64	CABLE TRAY & CONDUIT	CONTACT RAIL O.B. END APPR. 677+09.35	TRACTION POWER FEEDER	0	DC-2	2-1/C	#3/0	600V	90°C	125V	DC	0	NEW 200A ENCLOSED CIRCUIT BREAKER	CONDUIT	BATTERY	DC POWER FEEDER	0									
DP-3	4-1/C	1000 MCM	1000V	90°C	700V	DC	0		DC SWITCHGEAR UNIT NO.3 BKR. #61	CABLE TRAY & CONDUIT	CONTACT RAIL I.B. END APPR. 677+65.35	TRACTION POWER FEEDER	0	DC-3	2-1/C	#3/0	600V	90°C	125V	DC	0	NEW 200A ENCLOSED CIRCUIT BREAKER	CONDUIT	DC DISTRIBUTION PANEL DC-IPA	DC POWER	0									
DP-4	4-1/C	1000 MCM	1000V	90°C	700V	DC	0		DC SWITCHGEAR UNIT NO.4 BKR. #63	CABLE TRAY & CONDUIT	CONTACT RAIL I.B. END APPR. 677+09.35	TRACTION POWER FEEDER	0	DC-4	2/C	#6	600V	90°C	125V	DC	0	DC DISTRIBUTION PANEL DC-IPA	CABLE TRAY & CONDUIT	DC SWITCHGEAR UNIT NO.1 BKR. #62	DC POWER	0									
AN-1	4/C	#14	600V	90°C	125V	DC	2		BATTERY CHARGER	CONDUIT	RTU CABINET	BATTERY CHARGER ANNUNCIATION	0	DC-5	2/C	#10	600V	90°C	125V	DC	0	DC DISTRIBUTION PANEL DC-IPA	CABLE TRAY & CONDUIT	DC CKT. BKR. TEST CABINET	DC POWER	0									
AN-2	NOT USED													DC-6	2/C	#10	600V	90°C	125V	DC	0	DC DISTRIBUTION PANEL DC-IPA	CABLE TRAY & CONDUIT	EMERG. TRIP SWITCH RELAY CABINET	DC POWER	0									
AN-3	12/C	#14	600V	90°C	125V	DC	2		ETS RELAY CABINET	CONDUIT	RTU CABINET	ETS ANNUNCIATION	0	DC-7	2/C	#12	600V	90°C	125V	DC	0	DC DISTRIBUTION PANEL DC-IPA	CONDUIT	RTU	DC POWER	0									
SC-1	12/C	#14	600V	90°C	24V	DC	4		DC SWITCHGEAR UNIT NO.1 BKR. #62	CABLE TRAY & CONDUIT	DATA TRANSMISSION SYSTEM CABINET	CIRCUIT BREAKER CONTROL & INDICATION	0	DC-8	2/C	#12	600V	90°C	125V	DC	0	DC DISTRIBUTION PANEL DC-IPA	CONDUIT	NETWORK SWITCH	DC POWER	0									
SC-2	12/C	#14	600V	90°C	24V	DC	4		DC SWITCHGEAR UNIT NO.2 BKR. #64	CABLE TRAY & CONDUIT	DATA TRANSMISSION SYSTEM CABINET	CIRCUIT BREAKER CONTROL & INDICATION	0	DC-9	2/C	#12	600V	90°C	125V	DC	0	DC DISTRIBUTION PANEL DC-IPA	CONDUIT	EMERGENCY LIGHT	DC POWER	0									
SC-3	12/C	#14	600V	90°C	24V	DC	4		DC SWITCHGEAR UNIT NO.3 BKR. #61	CABLE TRAY & CONDUIT	DATA TRANSMISSION SYSTEM CABINET	CIRCUIT BREAKER CONTROL & INDICATION	0	DC-10	2/C	#12	600V	90°C	125V	DC	0	DC DISTRIBUTION PANEL DC-IPA	CONDUIT	HMI CABINET	DC POWER	0									
SC-4	12/C	#14	600V	90°C	24V	DC	4		DC SWITCHGEAR UNIT NO.4 BKR. #63	CABLE TRAY & CONDUIT	DATA TRANSMISSION SYSTEM CABINET	CIRCUIT BREAKER CONTROL & INDICATION	0	ET-1	4/C	#10	600V	90°C	125V	DC	2	EMER. TRIP SWITCH RELAY CABINET	CABLE TRAY & CONDUIT	DC SWITCHGEAR UNIT NO.1 BKR. #62	CONTACT RAIL EMER. TRIP	0									
SC-5	NOT USED													ET-2	4/C	#10	600V	90°C	125V	DC	2	EMER. TRIP SWITCH RELAY CABINET	CABLE TRAY & CONDUIT	DC SWITCHGEAR UNIT NO.2 BKR. #64	CONTACT RAIL EMER. TRIP	0									
SC-6	NOT USED													ET-3	4/C	#10	600V	90°C	125V	DC	2	EMER. TRIP SWITCH RELAY CABINET	CABLE TRAY & CONDUIT	DC SWITCHGEAR UNIT NO.3 BKR. #61	CONTACT RAIL EMER. TRIP	0									
SC-7	19/C	#14	600V	90°C	24V	DC	7		RTU CABINET	CABLE TRAY & CONDUIT	DATA TRANSMISSION SYSTEM CABINET	ANNUNCIATION		ET-4	4/C	#10	600V	90°C	125V	DC	2	EMER. TRIP SWITCH RELAY CABINET	CABLE TRAY & CONDUIT	DC SWITCHGEAR UNIT NO.4 BKR. #63	CONTACT RAIL EMER. TRIP	0									
AC-1	3/C	#10	600V	90°C	480 V	AC	0	1 GREEN GRD WIRE	NEW 480/277 VAC PANEL HA	CONDUIT	NEW 15 KVA TRANSFORMER	TRANSFORMER POWER	0	MA-1	1-1/C	#6	2000V	90°C	GRD.	0			DC SWITCHGEAR UNIT NO.1 BKR. #62	CONDUIT	STATION GROUND	LIGHTING ARRESTER GROUND	0								
AC-2	3/C	#10	600V	90°C	480 V	AC	0	1 GREEN GRD WIRE	NEW 480/277 VAC PANEL HA	CONDUIT	UNIT HEATER #1	480 VAC POWER TO UNIT HEATER	0	MA-2	1-1/C	#6	2000V	90°C	GRD.	0			DC SWITCHGEAR UNIT NO.2 BKR. #64	CONDUIT	STATION GROUND	LIGHTING ARRESTER GROUND	0								
AC-3	3/C	#10	600V	90°C	480 V	AC	0	1 GREEN GRD WIRE	NEW 480/277 VAC PANEL HA	CONDUIT	UNIT HEATER #2	480 VAC POWER TO UNIT HEATER	0	MA-3	1-1/C	#6	2000V	90°C	GRD.	0			DC SWITCHGEAR UNIT NO.3 BKR. #61	CONDUIT	STATION GROUND	LIGHTING ARRESTER GROUND	0								
AC-4	2/C	#12	600V	90°C	277 V	AC	0	1 GREEN GRD WIRE	NEW 480/277 VAC PANEL HA	CONDUIT	TBS INDOOR LIGHTS	LIGHTS A.C. FEED	0	MA-4	1-1/C	#6	2000V	90°C	GRD.	0			DC SWITCHGEAR UNIT NO.4 BKR. #63	CONDUIT	STATION GROUND	LIGHTING ARRESTER GROUND	0								
AC-5	4/C	#12	600V	90°C	480 V	AC	0	1 GREEN GRD WIRE	NEW 480/277 VAC PANEL HA	CONDUIT	BATTERY CHARGER	480 VAC POWER TO BATT. CHARGER	0	MA-5	NOT USED																				
AC-6	3/C	#12	600V	90°C	208 V	AC	0	1 GREEN GRD WIRE	NEW 15 KVA TRANSFORMER	CABLE TRAY AND CONDUIT	NEW 208V/120V A.C. PANEL LA	208/120 VAC POWER	0	MA-6	2/C	#10	600V	90°C	GRD.	0			DC SWITCHGEAR UNIT NO.1 BKR. #62	CABLE TRAY & CONDUIT	STATION GROUND	STRUCTURE GROUND RELAY	0								
AC-7	2/C	#12	600V	90°C	120 V	AC	0	1 GREEN GRD WIRE	NEW 208V/120V A.C. PANEL LA	CONDUIT	EXHAUST FAN #1	120 VAC POWER	0	MA-7	1-1/C	#10	2000V	90°C	700V	0			DC SWITCHGEAR UNIT NO.1 BKR. #62	CONDUIT	NEGATIVE POLARITY	NEG. POLARITY REFERENCE OR	0								
AC-8	3/C	#12	600V	90°C	120 V	AC	0	1 GREEN GRD WIRE	NEW 208V/120V A.C. PANEL LA	CABLE TRAY AND CONDUIT	NEW 3KVA ISOLATION TRANSFORMER. IT-1	120 VAC ISOLATED POWER	0	MA-8	1-1/C	#10	2000V	90°C	700V	0			DC SWITCHGEAR UNIT NO.4 BKR. #63	CONDUIT			0								
AC-9	2/C	#12	600V	90°C	120 V	AC	0		NEW 3KVA ISOLATION TRANSFORMER. IT-1	CABLE TRAY AND CONDUIT	DC SWITCHGEAR UNIT NO.1 BKR. #62	120 VAC ISOLATED POWER	0																						
AC-10	2/C	#12	600V	90°C	120 V	AC	0	1 GREEN GRD WIRE	NEW 208V/120V A.C. PANEL LA	CONDUIT	RTU	120 VAC POWER	0																						
AC-11	2/C	#10	600V	90°C	120 V	AC	0	1 GREEN GRD WIRE	NEW 208V/120V A.C. PANEL LA	CONDUIT	RECEPTACLES	120 VAC POWER	0																						
AC-12	2/C	#10	600V	90°C	120 V	AC	0	1 GREEN GRD WIRE	NEW 208V/120V A.C. PANEL LA	CONDUIT	RECEPTACLES	120 VAC POWER	0																						
AC-13	2/C	#10	600V	90°C	120 V	AC	0	1 GREEN GRD WIRE	NEW 208V/120V A.C. PANEL LA	CONDUIT	ROLL-UP DOOR	120 VAC POWER	0																						
AC-14	2/C	#10	600V	90°C	120 V	AC	0	1 GREEN GRD WIRE	NEW 208V/120V A.C. PANEL LA	CONDUIT	OUTDOOR LIGHT	120 VAC POWER	0																						
AC-15	2/C	#12	600V	90°C	120 V	AC	0	1 GREEN GRD WIRE	NEW 208V/120V A.C. PANEL LA	CONDUIT	BATTERY CYCLE MONITOR	120 VAC POWER	0																						

H - A.C. PRIMARY VOLTAGE CABLE AN - ANNUNCIATOR CABLE CN - OPERATING CONTROL CABLE
 DP - D.C. POSITIVE POWER CABLE SC - SUPERVISORY CONTROL CABLE MA - MISCELLANEOUS CIRCUITS
 DN - D.C. NEGATIVE POWER CABLE ET - EMERGENCY TRIP CABLE AC - A.C. LOW VOLTAGE POWER CIRCUITS
 DD - D.C. UTILITY DRAIN CABLE MT - METERING & INSTRUMENTATION CABLE DC - D.C. CONTROL POWER CIRCUITS

END APPR - END APPROACH OF CONTACT RAIL
 BOLD TEXT INDICATES NEW CABLES
 SCREENED TEXT INDICATES EXISTING TO REMAIN CABLES

NOTE:
 CABLES AN-1, AN-2, SC-7, AC-10, AC-15, DC-7, DC-8 AND DC-10, ARE SHOWN IN SCADA DRAWINGS ALSO FOR REFERENCE.

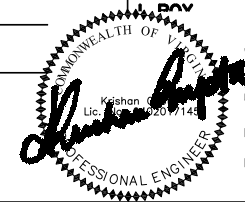

"PROFESSIONAL CERTIFICATION: I HEREBY CERTIFY THAT THESE DOCUMENTS WERE PREPARED OR APPROVED BY ME, AND THAT I AM A DULY LICENSED PROFESSIONAL ENGINEER UNDER THE LAWS OF THE COMMONWEALTH OF VIRGINIA."
 LICENSE No. 04020117145
 EXPIRATION DATE: 10/31/2015
 -VA Regulations 18VAC10-20-760

DESIGNED			DRAWN			CHECKED		
JAJ	4/4/15	DATE	JAJ	5/20/15	DATE	PK	6/1/15	DATE

REFERENCE DRAWINGS		REVISIONS	
NUMBER	TITLE	DATE	DESCRIPTION
		11/2/15	AMENDMENT NO. 1


WASHINGTON METROPOLITAN AREA TRANSIT AUTHORITY
 DEPARTMENT OF TRANSIT INFRASTRUCTURE AND ENGINEERING SERVICES
 CENI - POWER SYSTEMS ENGINEERING

REVISION SUBMITTED: _____ DATE: _____
 APPROVED: _____ DATE: _____
 DEPUTY CHIEF ENGINEER

SIX (6) TIE BREAKER STATIONS UPGRADES ORANGE AND BLUE LINES DC, MD AND VA
 K07TB2 - PROSPERITY AVE. TIE BREAKER STATION CONDUIT AND CABLE SCHEDULE

CONTRACT NO. FQ15237	SCALE NONE	DRAWING NO. K07TB2-TB-300	SHEET NO. 33 OF 60
-------------------------	---------------	------------------------------	-----------------------

Drawing File: H:\WMATA PROJECTS\FQ15237\DRG\TBS\K07TB2 - TB-401.DWG
 Plotted by: E013941 Date: Fri, 30 Oct 2015 Time: 10:46:45 am
 Xrefs: N:\ROBINSON-ELECT-MECH-ELEC-PWR AutoCAD Folder\WMATA CAD TEMPLATE\Library\CUPTA SIGNATURE.tif

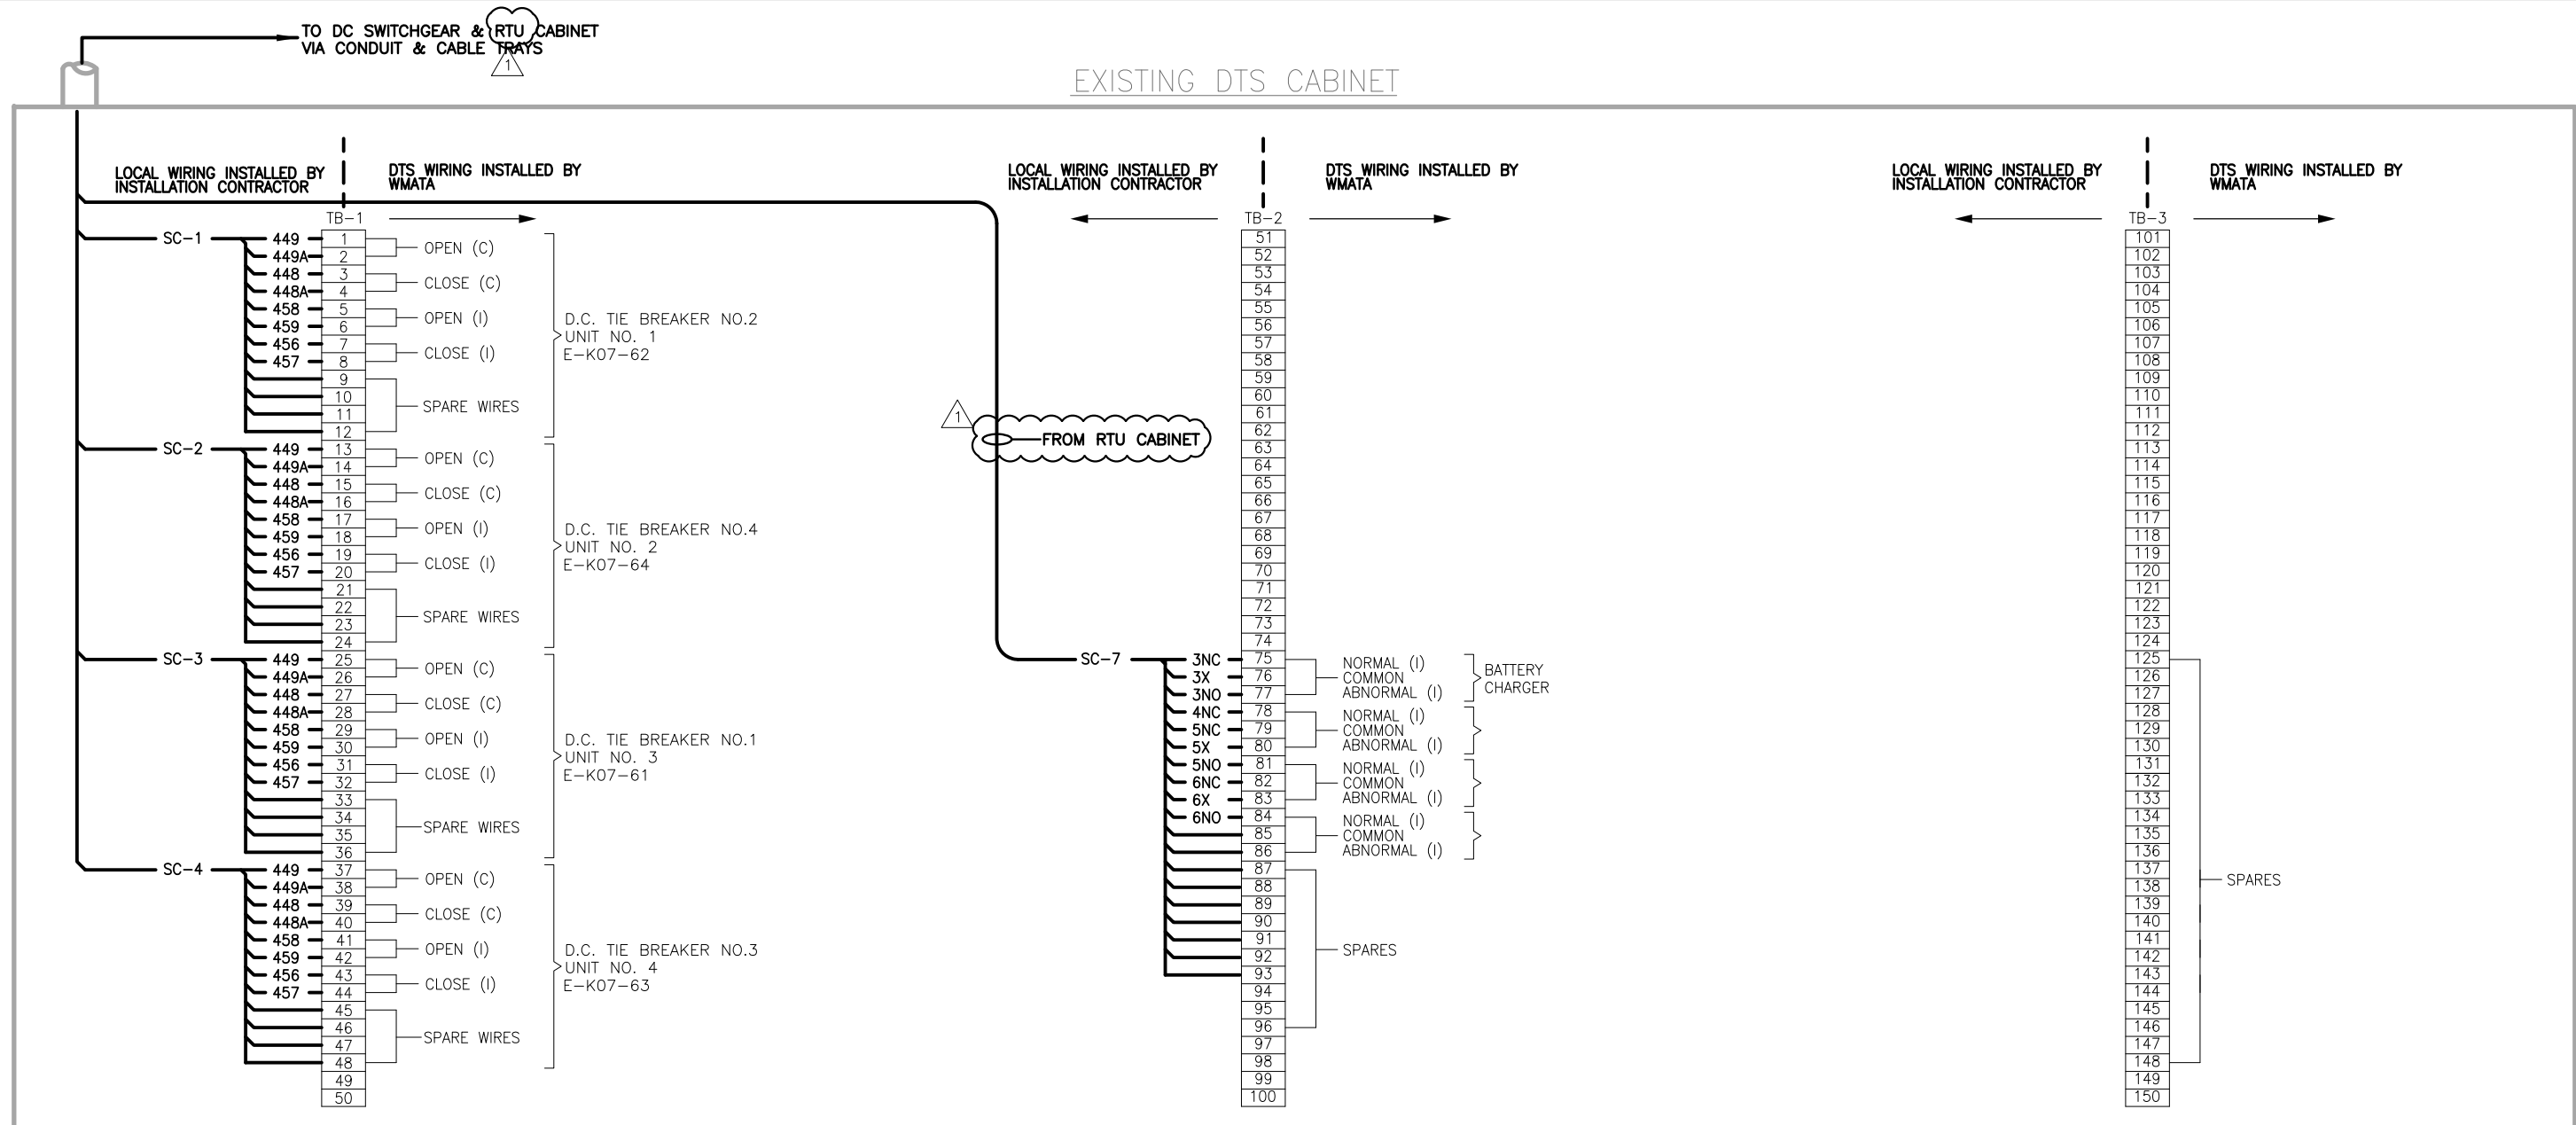

TIE BREAKER STATION

NOTES:

1. WIRING & TERMINATION FOR BATTERY CHARGER IS NOT REQUIRED WHEN D.C. POWER IS SUPPLIED FROM PASSENGER STATION. TERMINALS NOT USED WILL BECOME SPARES WITH JUMPER AT TERMINALS 76-75.
2. WHEN TWO TIE BREAKER STATIONS ARE IN THE SAME RTU CONTROL AREA, THE SECOND TIE BREAKER STATION WILL USE A DIFFERENT SERIES OF BREAKER NUMBERS. SEE TABLE AT LEFT.
3. FOR SECOND TIE BREAKER STATION, USE NUMERAL 6 INSTEAD OF 4.
4. SIX ADDITIONAL WIRES ARE BROUGHT TO DTS CABINET, THREE FOR ETS TRIP AND THREE SPARES. WMATA WILL CONNECT THEM TO TERMINAL BLOCKS AS REQUIRED.

LEGEND:
 (I) — DENOTES INDICATION
 (C) — DENOTES CONTROL
 * — SEE NOTE 2


FUNCTION	BRK NO.	1 ST TBS BRK NO.	2 ND TBS BRK NO.	YARD AREA INTERFACE BRK NO.
DC TIE BRK NO.	1	41	61	81
	2	42	62	82
	3	43	63	83
	4	44	64	84
	5	45	65	85
	6	46	66	86
	7	47	67	87
	8	48	68	88



"PROFESSIONAL CERTIFICATION: I HEREBY CERTIFY THAT THESE DOCUMENTS WERE PREPARED OR APPROVED BY ME, AND THAT I AM A DULY LICENSED PROFESSIONAL ENGINEER UNDER THE LAWS OF THE COMMONWEALTH OF VIRGINIA."
 LICENSE No. 04020117145
 EXPIRATION DATE: 10/31/2015

REFERENCE DRAWINGS			REVISIONS			WASHINGTON METROPOLITAN AREA TRANSIT AUTHORITY		SIX (6) TIE BREAKER STATIONS UPGRADES ORANGE AND BLUE LINES DC, MD AND VA							
DESIGNED	JAJ	4/4/15	NUMBER	TITLE	DATE	NUM	DESCRIPTION	DEPARTMENT OF TRANSIT INFRASTRUCTURE AND ENGINEERING SERVICES				CONTRACT NO. FQ15237	SCALE NONE	DRAWING NO. K07TB2-TB-401	SHEET NO. 35 OF 60
DRAWN	JAJ	5/20/15			11/2/15	Δ	AMENDMENT NO. 1	CENI - POWER SYSTEMS ENGINEERING							
CHECKED	PK	6/1/15						REVISION SUBMITTED				APPROVED			
						DATE				DATE					
						DEPUTY CHIEF ENGINEER									

Drawing File: H:\WMATA PROJECTS\FQ15237\DRG\TBS\G01TBS - BENNING RD TBS\G01TBS-TB-200.DWG
 Plotted by: E013941 Date: Fri, 30 Oct 2015 Time: 10:46:52 am
 Xrefs: .\..\..\DES\ARCH\G01TBS - BENNING RD TBS FLOOR PLAN.dwg ; .\..\..\DES\TBS\G01TBS - BENNING RD TBS DESIGN FILE.dwg
 Images: .\..\ROBINSON-ELECT-MECH\ELEC-MECH-PWR AutoCAD Folder\WMATA CAD TEMPLATE\Library\GUPTA SIGNATURE.tif

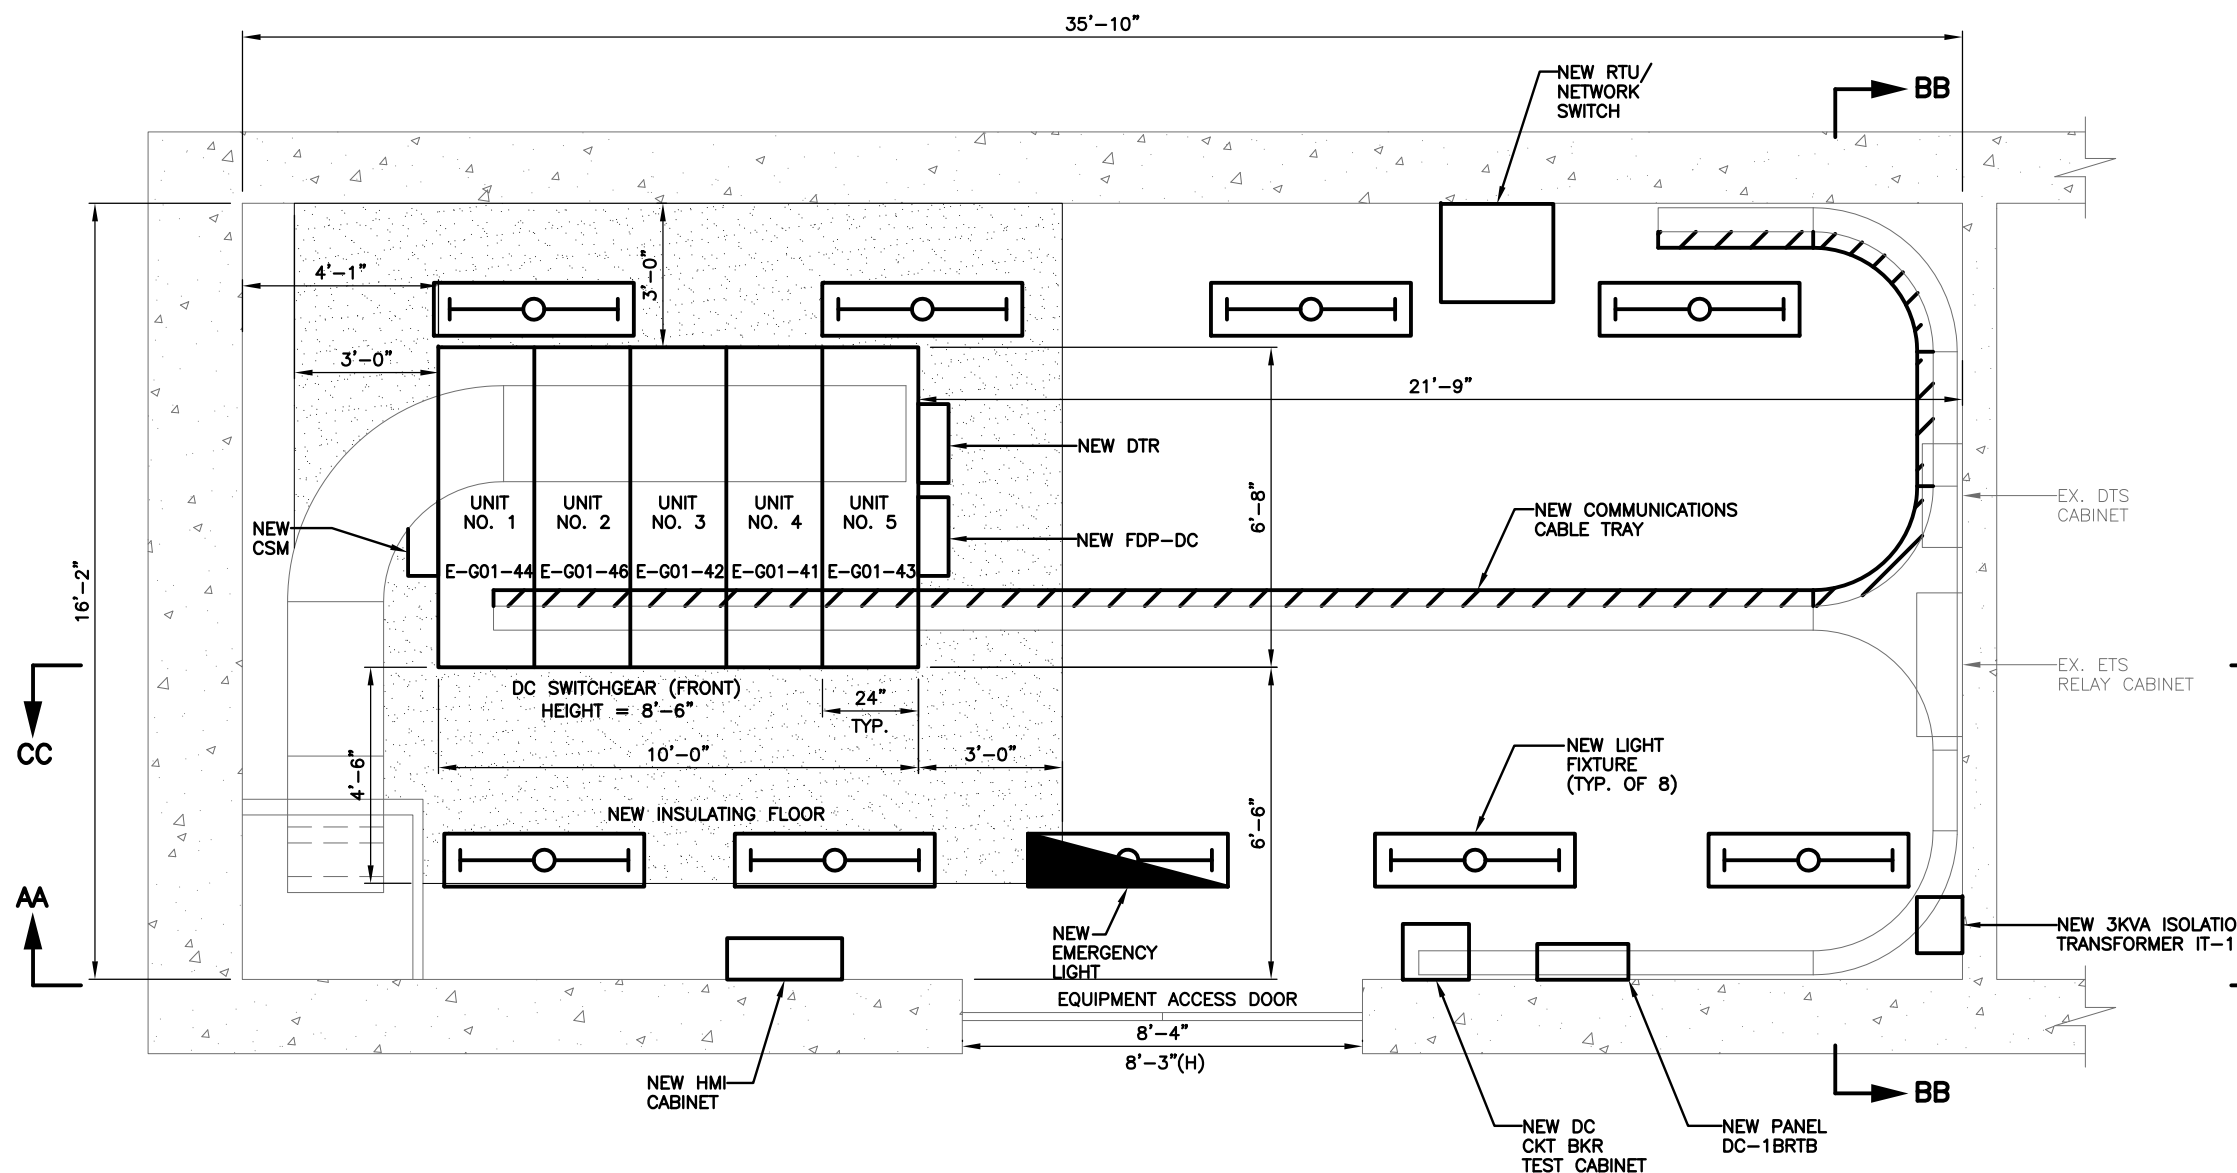

- DESCRIPTION OF MAJOR WORK**
- REMOVE EXISTING DC SWITCHGEAR AND PROVIDE AND INSTALL NEW DC SWITCHGEAR.
 - PROVIDE AND INSTALL A NEW 3KVA ISOLATION TRANSFORMER IT1 WITH PANEL.
 - REMOVE EXISTING DC CIRCUIT BREAKER TEST CABINET AND PROVIDE AND INSTALL NEW DC CIRCUIT BREAKER TEST CABINET.
 - REMOVE EXISTING DC DISTRIBUTION PANEL AND PROVIDE AND INSTALL NEW DC DISTRIBUTION PANEL DC-1BRTB.
 - REMOVE EXISTING LIGHT FIXTURES AND PROVIDE AND INSTALL NEW LIGHT FIXTURES AND PROVIDE AND INSTALL NEW EMERGENCY LIGHT FIXTURE. SEE GENERAL NOTES FOR WIRING INFORMATION.
 - REMOVE EXISTING DC TO AC INVERTER.
 - REMOVE EXISTING INSULATING FLOOR AND PROVIDE AND INSTALL NEW INSULATING FLOOR.
 - REMOVE EXISTING ANNUNCIATOR PANEL AND ALL ASSOCIATED CABLING.
 - REPLACE 5 RECEPTACLES IN THE ROOM. EXISTING BRANCH CIRCUIT WIRING SHALL BE REUSED.

- DESCRIPTION OF SCADA WORK:**
- PROVIDE AND INSTALL NEW HMI CABINET.
 - PROVIDE AND INSTALL NEW CABLE SHIELD MONITOR(CSM).
 - PROVIDE AND INSTALL NEW RTU/NETWORK SWITCH CABINET.
 - PROVIDE AND INSTALL NEW DIGITAL TRACE RECORDER (DTR).
 - PROVIDE AND INSTALL NEW FIBER DISTRIBUTION PANEL FOR DC SWITCHGEAR (FDP-DC).
 - PROVIDE AND INSTALL A 8 INCH WIDE MINIMUM WIRE-MESH TYPE COMMUNICATION CABLE TRAY, ALONG WITH SUPPORTS, GROUNDING, ISOLATION AND FITTING REQUIREMENTS AS PER THE MANUFACTURER'S RECOMMENDATION, IN COMPLIANT WITH NEC'S FILL CRITERIA AND WMATA'S SPECIFICATION.

A | **EQUIPMENT LAYOUT PLAN - NEW**
 G01TBS-TB-200 | BENNING RD. TBS | G01TBS-TB-202 | SCALE: 1/2"=1'-0"

"PROFESSIONAL CERTIFICATION: I HEREBY CERTIFY THAT THESE DOCUMENTS WERE PREPARED OR APPROVED BY ME, AND THAT I AM A DULY LICENSED PROFESSIONAL ENGINEER UNDER THE LAWS OF THE COMMONWEALTH OF VIRGINIA."
 LICENSE No. 04020117145
 EXPIRATION DATE: 10/31/2015
 -VA Regulations 18VAC10-20-760

DESIGNED	JAJ	4/4/15
		DATE
DRAWN	JAJ	5/20/15
		DATE
CHECKED	PK	6/1/15
		DATE

REFERENCE DRAWINGS	
NUMBER	TITLE

REVISIONS		
DATE	NUM	DESCRIPTION
11/2/15	Δ	AMENDMENT NO. 1

WASHINGTON METROPOLITAN AREA TRANSIT AUTHORITY
DEPARTMENT OF TRANSIT INFRASTRUCTURE AND ENGINEERING SERVICES
CENI - POWER SYSTEMS ENGINEERING

REVISION SUBMITTED _____ DATE _____
 APPROVED _____ DATE _____
 DEPUTY CHIEF ENGINEER

SIX (6) TIE BREAKER STATIONS UPGRADES ORANGE AND BLUE LINES DC, MD AND VA G01 - BENNING RD. TIE BREAKER STATION EQUIPMENT LAYOUT PLAN - NEW		CONTRACT NO.	SCALE	DRAWING NO.	SHEET NO.
		FQ15237	AS NOTED	G01TBS-TB-200	38 OF 60

Drawing File: H:\WMATA PROJECTS\FQ15237\DRG\TBS\G01TBS - BENNING RD TBS\G01TBS-TB-300.DWG
 Plotted by: E013941 Date: Fri, 30 Oct 2015 Time: 10:47:05 am
 Xrefs: N:\ROBINSON-ELECT-MECH\ELEC-MECH-PWR AutoCAD Folder\WMATA CAD TEMPLATE\Library\CUIPTA SIGNATURE.tif

CABLE					CIRCUIT			ROUTING				CABLE					CIRCUIT			ROUTING						
NUMBER	CONSTRUCT.	SIZE AWG.	INSULATION		VOLTAGE	A.C. OR D.C.	SPARE COND.	FROM	VIA	TO	FOR	REV. NO.	NUMBER	CONSTRUCT.	SIZE AWG.	INSULATION		VOLTAGE	A.C. OR D.C.	SPARE COND.	FROM	VIA	TO	FOR	REV. NO.	
			VOLTAGE	TYPE												VOLTAGE	TYPE									
DP-1	5-1/C	1000 MCM	1000V	90°C	700V	DC	0	DC SWITCHGEAR UNIT NO.1 BKR. #4	CABLE TRENCH & CONDUIT	CONTACT RAIL I.B. END APPR. 337+55.36	TRACTION POWER FEEDER	0	DC-1	NOT USED												
DP-2	4-1/C	1000 MCM	1000V	90°C	700V	DC	0	DC SWITCHGEAR UNIT NO.2 BKR. #5	CABLE TRENCH & CONDUIT	CONTACT RAIL I.B. END APPR. 338+63.36	TRACTION POWER FEEDER	0	DC-2	2/C	#12	600V	90°C	125V	DC	0	DC DISTRIBUTION PANEL DC-1BRTB	CONDUIT	HMI CABINET	DC POWER	0	
DP-3	4-1/C	1000 MCM	1000V	90°C	700V	DC	0	DC SWITCHGEAR UNIT NO.3 BKR. #2	CABLE TRENCH & CONDUIT	CONTACT RAIL I.B. END APPR. 338+91.36	TRACTION POWER FEEDER	0	DC-3	2-1/C	#4/0	600V	90°C	125V	DC	0	225A, 2P 125V BKR IN AC SWBD RM	CONDUIT	DC DISTRIBUTION PANEL DC-1BRTB	DC POWER FEEDER	0	
DP-4	2-1/C	1000 MCM	1000V	90°C	700V	DC	0	DC SWITCHGEAR UNIT NO.4 BKR. #1	CABLE TRENCH & CONDUIT	CONTACT RAIL O.B. END APPR. 338+91.36	TRACTION POWER FEEDER	0	DC-4	2/C	#6	600V	90°C	125V	DC	0	DC DISTRIBUTION PANEL DC-1BRTB	CABLE TRAY & CONDUIT	DC SWITCHGEAR UNIT NO.3 BKR. #2	DC CNTRL POWER	0	
DP-5	4-1/C	1000 MCM	1000V	90°C	700V	DC	0	DC SWITCHGEAR UNIT NO.5 BKR. #3	CABLE TRENCH & CONDUIT	CONTACT RAIL O.B. END APPR. 338+35.36	TRACTION POWER FEEDER	0	DC-5	NOT USED												
AN-1	NOT USED												DC-6	2/C	#12	600V	90°C	125V	DC	0	DC DISTRIBUTION PANEL DC-1BRTB	CONDUIT	DC CKT. BKR. TEST CABINET	DC POWER	0	
AN-2	NOT USED												DC-7	2/C	#12	600V	90°C	125V	DC	0	DC DISTRIBUTION PANEL DC-1BRTB	CABLE TRAY & CONDUIT	EMERG. TRIP SW. RELAY CAB	DC POWER	0	
AN-3	NOT USED												DC-8	2/C	#12	600V	90°C	125V	DC	0	DC DISTRIBUTION PANEL DC-1BRTB	CONDUIT	NETWORK SWITCH	DC POWER	0	
AN-4	NOT USED												DC-9	2/C	#12	600V	90°C	125V	DC	0	DC DISTRIBUTION PANEL DC-1BRTB	CABLE TRAY & CONDUIT	RTU	DC POWER	0	
AN-5	12/C	#14	600V	90°C	125V	DC	2	EMER. TRIP SWITCH RELAY CAB	CABLE TRAY & CONDUIT	RTU CABINET	ETS ANNUNCIATION	0	DC-10	2/C	#12	600V	90°C	125V	DC	0	DC DISTRIBUTION PANEL DC-1BRTB	CABLE TRAY & CONDUIT	EMERGENCY LIGHT	DC POWER	0	
													ET-1	4/C	#10	600V	90°C	125V	DC	2	EMER. TRIP SWITCH RELAY CABINET	CABLE TRAY & CONDUIT	DC SWITCHGEAR UNIT NO.1 BKR. #4	CONTACT RAIL EMER. TRIP	0	
													ET-2	4/C	#10	600V	90°C	125V	DC	2	EMER. TRIP SWITCH RELAY CABINET	CABLE TRAY & CONDUIT	DC SWITCHGEAR UNIT NO.2 BKR. #5	CONTACT RAIL EMER. TRIP	0	
													ET-3	4/C	#10	600V	90°C	125V	DC	2	EMER. TRIP SWITCH RELAY CABINET	CABLE TRAY & CONDUIT	DC SWITCHGEAR UNIT NO.3 BKR. #2	CONTACT RAIL EMER. TRIP	0	
													ET-4	4/C	#10	600V	90°C	125V	DC	2	EMER. TRIP SWITCH RELAY CABINET	CABLE TRAY & CONDUIT	DC SWITCHGEAR UNIT NO.4 BKR. #1	CONTACT RAIL EMER. TRIP	0	
													ET-5	4/C	#10	600V	90°C	125V	DC	2	EMER. TRIP SWITCH RELAY CABINET	CABLE TRAY & CONDUIT	DC SWITCHGEAR UNIT NO.5 BKR. #3	CONTACT RAIL EMER. TRIP	0	
													AC-1	3/C	#12 #12	600V	90°C	120V	AC	0	1 GREEN GRD WIRE	EX. 208V/120V AC PANEL WR	CONDUIT	NEW 3KVA ISOLATION TRANSFORMER IT1	IT1 FEED	0
													AC-2	2/C	#12	600V	90°C	120V	AC	0		NEW ISOLATION TRANSFORMER IT1	CONDUIT	DC SWITCHGEAR UNIT NO.1 BKR. #4	SWGR HEATER	0
													AC-3	NOT USED												
													AC-4	3/C	#12 #12	600V	90°C	120V	AC	0	1 GREEN GRD WIRE	EX. 208V/120V AC PANEL WR	CONDUIT	RTU	AC POWER	0
													AC-7	3-1/C	#12	600V	90°C	277V	AC	0	1 GREEN GRD WIRE	EX. A.C. 480V/277V PANEL WL	CONDUIT	TBS LIGHTS	TBS LIGHTING	0
SC-1	12/C	#14	600V	90°C	24V	DC	5	DC SWITCHGEAR UNIT NO.1 BKR. #4	CABLE TRAY & CONDUIT	SUPERVISORY CONT. TERMINAL BOX	CIRCUIT BREAKER CONTROL & INDICATION	0														
SC-2	12/C	#14	600V	90°C	24V	DC	5	DC SWITCHGEAR UNIT NO.2 BKR. #5	CABLE TRAY & CONDUIT	SUPERVISORY CONT. TERMINAL BOX	CIRCUIT BREAKER CONTROL & INDICATION	0	MA-1	1-1/C	#6	2000V	90°C	GRD.	DC	0	DC SWITCHGEAR UNIT NO.1 BKR. #4	CONDUIT	STATION GROUND	LIGHTING ARRESTER GROUND	0	
SC-3	12/C	#14	600V	90°C	24V	DC	5	DC SWITCHGEAR UNIT NO.3 BKR. #2	CABLE TRAY & CONDUIT	SUPERVISORY CONT. TERMINAL BOX	CIRCUIT BREAKER CONTROL & INDICATION	0	MA-2	1-1/C	#6	2000V	90°C	GRD.	DC	0	DC SWITCHGEAR UNIT NO.2 BKR. #5	CONDUIT	STATION GROUND	LIGHTING ARRESTER GROUND	0	
SC-4	12/C	#14	600V	90°C	24V	DC	5	DC SWITCHGEAR UNIT NO.4 BKR. #1	CABLE TRAY & CONDUIT	SUPERVISORY CONT. TERMINAL BOX	CIRCUIT BREAKER CONTROL & INDICATION	0	MA-3	1-1/C	#6	2000V	90°C	GRD.	DC	0	DC SWITCHGEAR UNIT NO.3 BKR. #2	CONDUIT	STATION GROUND	LIGHTING ARRESTER GROUND	0	
SC-5	12/C	#14	600V	90°C	24V	DC	5	DC SWITCHGEAR UNIT NO.5 BKR. #3	CABLE TRAY & CONDUIT	SUPERVISORY CONT. TERMINAL BOX	CIRCUIT BREAKER CONTROL & INDICATION	0	MA-4	1-1/C	#6	2000V	90°C	GRD.	DC	0	DC SWITCHGEAR UNIT NO.4 BKR. #1	CONDUIT	STATION GROUND	LIGHTING ARRESTER GROUND	0	
SC-6	19/C	#14	600V	90°C	24V	DC	1	RTU CABINET	CABLE TRAY & CONDUIT	SUPERVISORY CONT. TERMINAL BOX	ANNUNCIATION	0	MA-5	1-1/C	#6	2000V	90°C	GRD.	DC	0	DC SWITCHGEAR UNIT NO.5 BKR. #3	CONDUIT	STATION GROUND	LIGHTING ARRESTER GROUND	0	
													MA-6	1-1/C	#10	2000V	90°C	GRD.	DC	0	DC SWITCHGEAR UNIT NO.3 BKR. #2	CABLE TRAY & CONDUIT	STATION GROUND	GROUND RELAYING	0	
													MA-7	1-1/C	#10	2000V	90°C	700V	DC	0	DC SWITCHGEAR UNIT NO.3 BKR. #2	CONDUIT	JUNCTION BOX	NEG. POLARITY REFERENCE	0	
													MA-8	1-1/C	#10	2000V	90°C	700V	DC	0	DC SWITCHGEAR UNIT NO.4 BKR. #1	CONDUIT			0	

H - A.C. PRIMARY VOLTAGE CABLE
 DP - D.C. POSITIVE POWER CABLE
 DN - D.C. NEGATIVE POWER CABLE
 DD - D.C. UTILITY DRAIN CABLE
 AN - ANNUNCIATOR CABLE
 SC - SUPERVISORY CONTROL CABLE
 ET - EMERGENCY TRIP CABLE
 MT - METERING & INSTRUMENTATION CABLE
 CN - OPERATING CONTROL CABLE
 MA - MISCELLANEOUS CIRCUITS
 AC - A.C. LOW VOLTAGE POWER CIRCUITS
 DC - D.C. CONTROL POWER CIRCUITS

END APPR - END APPROACH OF CONTACT RAIL
 CSM - CABLE SHIELD MONITORING CABLE
 *** BOLD TEXT INDICATES NEW CABLES
 *** SCREENED TEXT INDICATES EXISTING TO REMAIN CABLES

NOTE:
 CABLES AN-5, SC-6, AC-4, DC-2, DC-8 AND DC-9 ARE SHOWN ON SCADA DRAWINGS ALSO FOR REFERENCE



"PROFESSIONAL CERTIFICATION: I HEREBY CERTIFY THAT THESE DOCUMENTS WERE PREPARED OR APPROVED BY ME, AND THAT I AM A DULY LICENSED PROFESSIONAL ENGINEER UNDER THE LAWS OF THE COMMONWEALTH OF VIRGINIA."
 LICENSE No. 04020117145
 EXPIRATION DATE: 10/31/2015
 -VA Regulations 18VAC10-20-760

REFERENCE DRAWINGS			REVISIONS		
NUMBER	TITLE	DATE	NUM	DESCRIPTION	
		11/2/15	Δ	AMENDMENT NO. 1	


WASHINGTON METROPOLITAN AREA TRANSIT AUTHORITY
 DEPARTMENT OF TRANSIT INFRASTRUCTURE AND ENGINEERING SERVICES
 CENI - POWER SYSTEMS ENGINEERING

REVISION SUBMITTED: _____ DATE: _____
 APPROVED: _____ DATE: _____
 DEPUTY CHIEF ENGINEER

SIX (6) TIE BREAKER STATIONS UPGRADES ORANGE AND BLUE LINES DC, MD AND VA
 G01 - BENNING RD. TIE BREAKER STATION CONDUIT AND CABLE SCHEDULE

CONTRACT NO. FQ15237	SCALE NONE	DRAWING NO. G01TBS-TB-300	SHEET NO. 41 OF 60
-------------------------	---------------	------------------------------	-----------------------

Drawing File: H:\WMATA\PROJECTS\FQ15237\DRG\TBS\G01TBS - BENNING RD TBS\G01TBS-TB-401.DWG
 Plotted by: E013941 Date: Fri, 30 Oct 2015 Time: 10:47:10 am
 Xrefs: N:\ROBINSON-ELECT-MECH\ELEC-MECH-PWR AutoCAD Folder\WMATA CAD TEMPLATE\Library\GUPTA SIGNATURE.tif

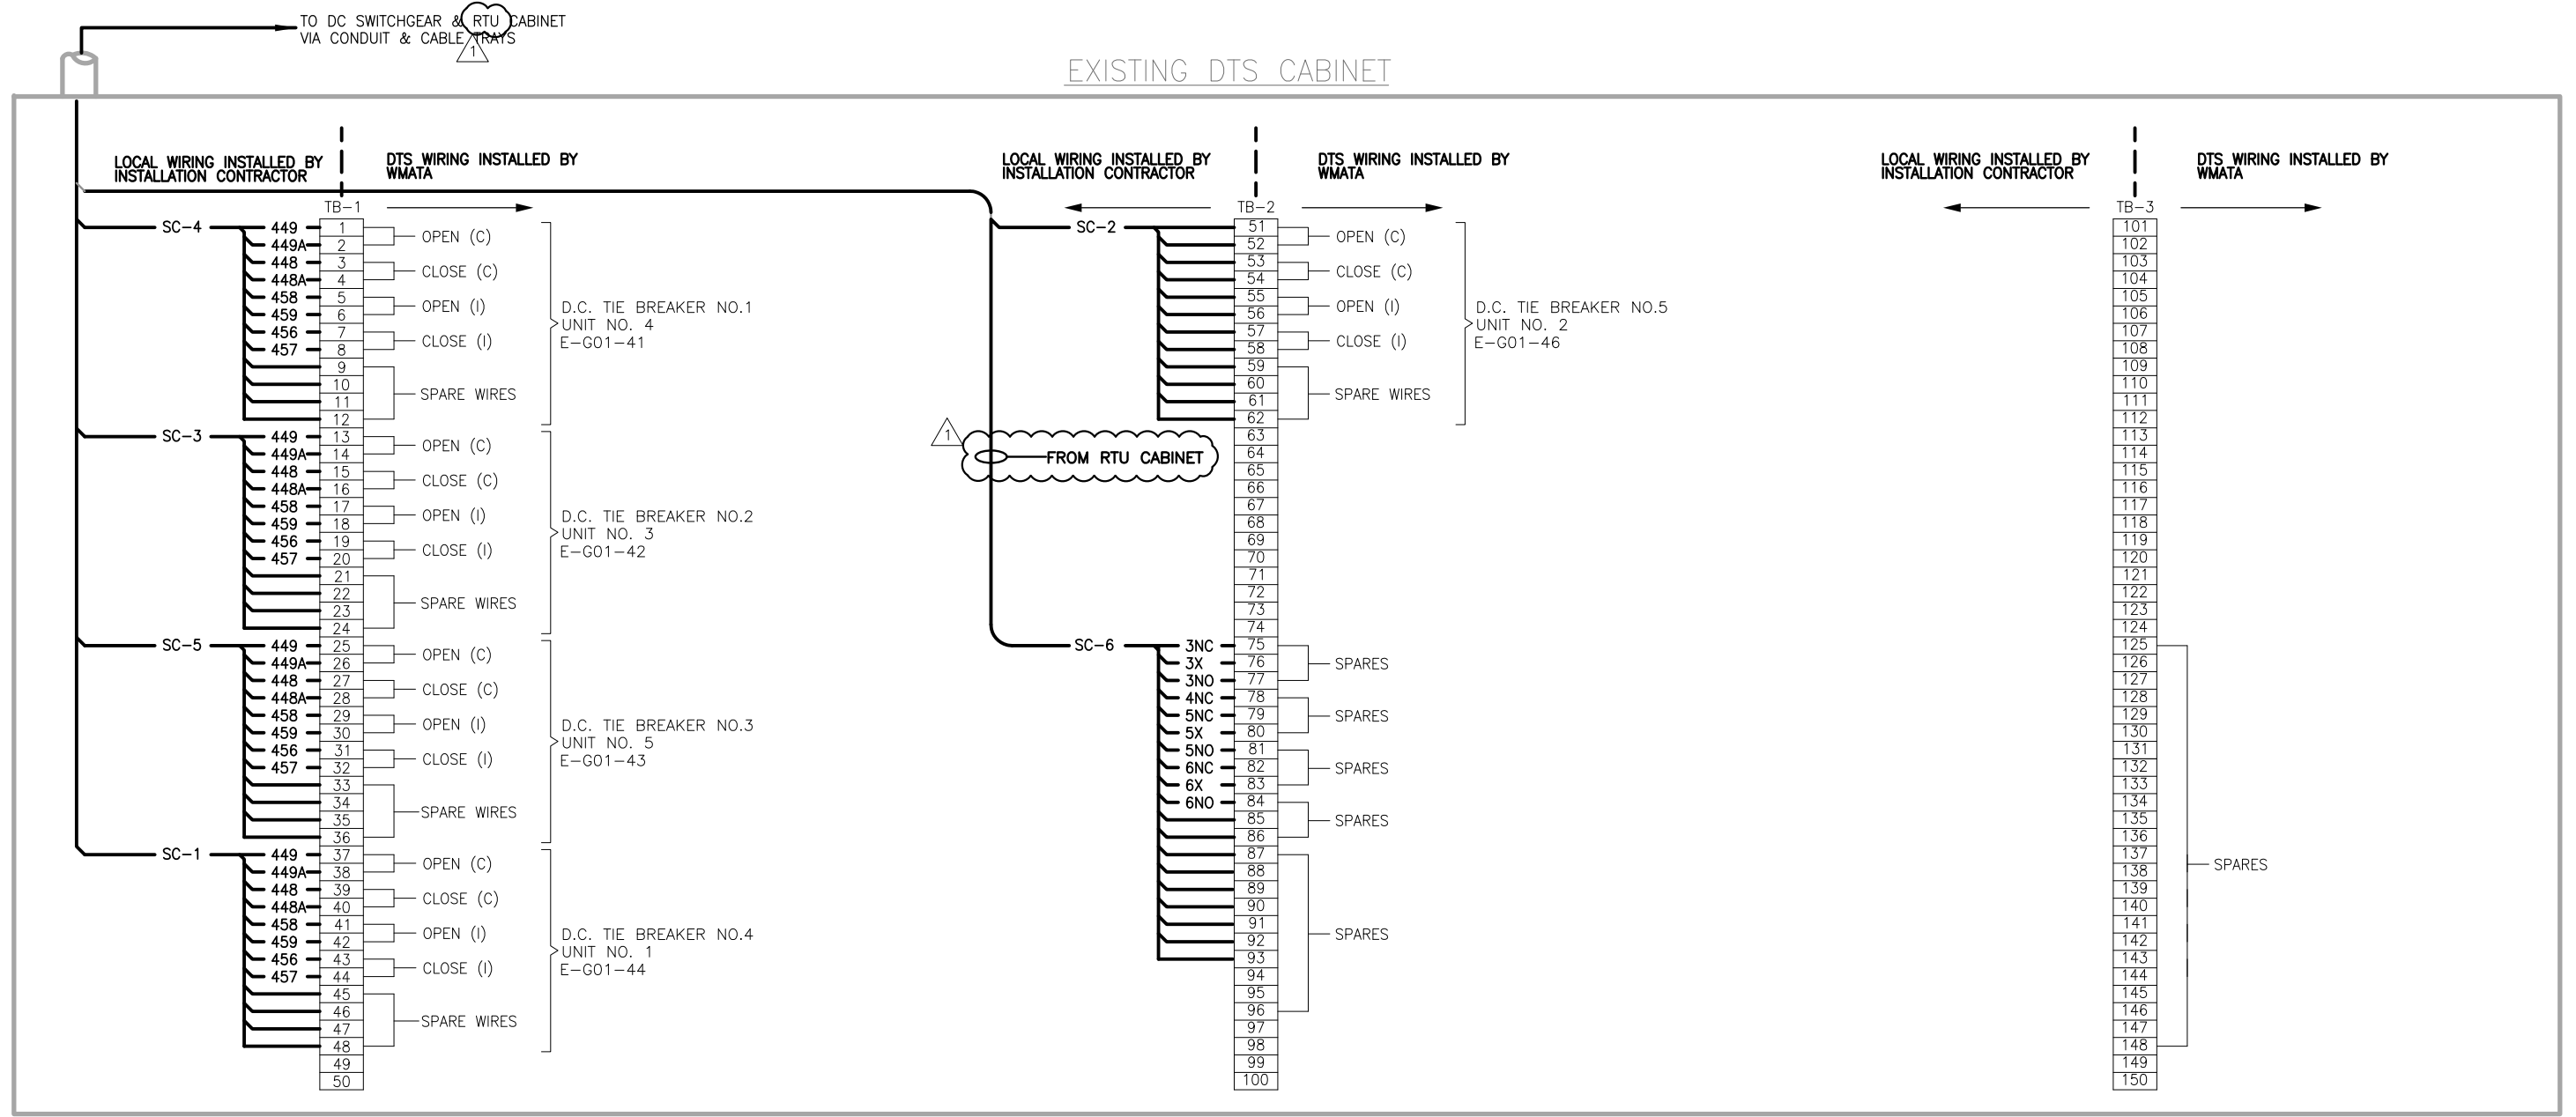

TIE BREAKER STATION

NOTES:

1. WIRING & TERMINATION FOR BATTERY CHARGER IS NOT REQUIRED WHEN D.C. POWER IS SUPPLIED FROM PASSENGER STATION. TERMINALS NOT USED WILL BECOME SPARES WITH JUMPER AT TERMINALS 76-75.
2. WHEN TWO TIE BREAKER STATIONS ARE IN THE SAME RTU CONTROL AREA, THE SECOND TIE BREAKER STATION WILL USE A DIFFERENT SERIES OF BREAKER NUMBERS. SEE TABLE AT LEFT.
3. FOR SECOND TIE BREAKER STATION, USE NUMERAL 6 INSTEAD OF 4.
4. SIX ADDITIONAL WIRES ARE BROUGHT TO DTS CABINET, THREE FOR ETS TRIP AND THREE SPARES. WMATA WILL CONNECT THEM TO TERMINAL BLOCKS AS REQUIRED.

LEGEND:
 (I) — DENOTES INDICATION
 (C) — DENOTES CONTROL
 * — SEE NOTE 2

FUNCTION	BRK NO.	1 ST TBS BRK NO.	2 ND TBS BRK NO.	YARD AREA INTERFACE BRK NO.
DC TIE BRK NO.	1	41	61	81
	2	42	62	82
	3	43	63	83
	4	44	64	84
	5	45	65	85
	6	46	66	86
	7	47	67	87
	8	48	68	88



"PROFESSIONAL CERTIFICATION: I HEREBY CERTIFY THAT THESE DOCUMENTS WERE PREPARED OR APPROVED BY ME, AND THAT I AM A DULY LICENSED PROFESSIONAL ENGINEER UNDER THE LAWS OF THE COMMONWEALTH OF VIRGINIA."
 LICENSE No. 04020117145
 EXPIRATION DATE: 10/31/2015

-VA Regulations 18VAC10-20-760

DESIGNED			DRAWN			CHECKED		
JAJ	4/4/15	DATE	JAJ	5/20/15	DATE	PK	6/1/15	DATE

REFERENCE DRAWINGS		REVISIONS	
NUMBER	TITLE	DATE	DESCRIPTION
		11/2/15	AMENDMENT NO. 1


WASHINGTON METROPOLITAN AREA TRANSIT AUTHORITY
 DEPARTMENT OF TRANSIT INFRASTRUCTURE AND ENGINEERING SERVICES
 CENI - POWER SYSTEMS ENGINEERING

REVISION SUBMITTED _____ DATE _____ APPROVED _____ DATE _____
 DEPUTY CHIEF ENGINEER


SIX (6) TIE BREAKER STATIONS UPGRADES ORANGE AND BLUE LINES DC, MD AND VA		CONTRACT NO. FQ15237		SCALE NONE		DRAWING NO. G01TBS-TB-401		SHEET NO. 43 OF 60	
--	--	----------------------	--	------------	--	---------------------------	--	--------------------	--

Drawing File: H:\WMATA PROJECTS\FQ15237\DRG\TBS\G01TBS - BENNING RD TBS\G01TBS-TB-500.DWG
 Plotted by: E013941 Date: Fri, 30 Oct 2015 Time: 10:47:20 am
 Xrefs: N:\ROBINSON-ELECT-MECH\ELEC-MECH-PWR AutoCAD Folder\WMATA CAD TEMPLATE\Library\GUPTA SIGNATURE.tif

FROM DC PANEL IN AC ROOM

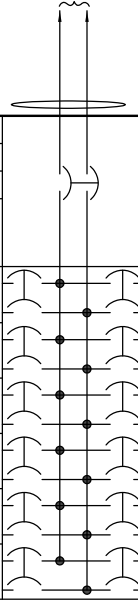

PANEL NAME:		PANEL DC-1BRTB				LOCATION:		BENNING ROAD TIE BREAKER STATION			
PANEL TYPE:		DC DISTRIBUTION				MAIN:		200A MCB			
BUS RATING:		125VDC - 225A MAX				PANEL:		SURFACE MOUNTED			
DESCRIPTION	CONNECTED LOAD (KVA)		CKT BKR TRIP	CKT NO.	Diagram	CKT NO.	CKT BKR TRIP	CONNECTED LOAD (KVA)		DESCRIPTION	
	AØ	BØ						AØ	BØ		
DC CONTROL POWER	0		60	1		2	20	0		SPARE	
DC CIRCUIT BREAKER TEST CABINET		0	30	3		4	30			EMERGENCY TRIP SWITCH RELAY CABINET	
HMI CABINET			20	5		6	20	0	0	EMERGENCY LIGHT FIXTURE	
RTU			20	7		8	20			NETWORK SWITCH	
SPACE				9		10				SPACE	
SPACE				11		12				SPACE	
SUB-TOTAL	0	0						0	0	SUB-TOTAL	
		TOTAL CONN. LOAD									
PHASE A	0	KVA									
PHASE B	0	KVA									
	0.00	KVA									
	0.00	AMP									

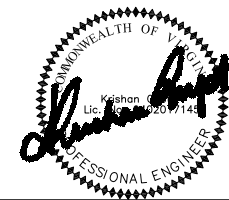

"PROFESSIONAL CERTIFICATION: I HEREBY CERTIFY THAT THESE DOCUMENTS WERE PREPARED OR APPROVED BY ME, AND THAT I AM A DULY LICENSED PROFESSIONAL ENGINEER UNDER THE LAWS OF THE COMMONWEALTH OF VIRGINIA."
 LICENSE No. 04020117145
 EXPIRATION DATE: 10/31/2015

-VA Regulations 18VAC10-20-760

DESIGNED			DRAWN			CHECKED		
JAJ	4/4/15	DATE	JAJ	5/20/15	DATE	PK	6/1/15	DATE

REFERENCE DRAWINGS		REVISIONS		
NUMBER	TITLE	DATE	NUM	DESCRIPTION
		11/2/15	1	AMENDMENT NO. 1

WASHINGTON METROPOLITAN AREA TRANSIT AUTHORITY
 metro
DEPARTMENT OF TRANSIT INFRASTRUCTURE AND ENGINEERING SERVICES
CENI - POWER SYSTEMS ENGINEERING

REVISION SUBMITTED _____ DATE _____ APPROVED _____ DATE _____
 DEPUTY CHIEF ENGINEER

SIX (6) TIE BREAKER STATIONS UPGRADES
ORANGE AND BLUE LINES DC, MD AND VA
 G01 - BENNING RD. TIE BREAKER STATION
 PANELBOARD SCHEDULE


CONTRACT NO. FQ15237	SCALE NONE	DRAWING NO. G01TBS-TB-500	SHEET NO. 44 OF 60
-------------------------	---------------	------------------------------	-----------------------

CABLE					CIRCUIT			ROUTING				CABLE					CIRCUIT			ROUTING						
NUMBER	CONSTRUCT.	SIZE AWG.	INSULATION		VOLTAGE	A.C. OR D.C.	SPARE COND.	FROM	VIA	TO	FOR	REV. NO.	NUMBER	CONSTRUCT.	SIZE AWG.	INSULATION		VOLTAGE	A.C. OR D.C.	SPARE COND.	FROM	VIA	TO	FOR	REV. NO.	
			VOLTAGE	TYPE												VOLTAGE	TYPE									
DP-1	5-1/C	1000 MCM	1000V	90°C	700V	DC	0	DC SWGR. UNIT NO.1 TBKR. NO.1	CABLE TRAY & CONDUIT	CONTACT RAIL O.B. END APPR. 396+31	TRACTION POWER FEEDER	0	DC-1	2-1/C	#4	600V	90°C	125V	DC	0	BATTERY CHARGER	CONDUIT	NEW 200A ENCLOSED CIRCUIT BREAKER	BATTERY CHARGING DC FEED	0	
DP-2	5-1/C	1000 MCM	1000V	90°C	700V	DC	0	DC SWGR. UNIT NO.2 TBKR. NO.3	CABLE TRAY & CONDUIT	CONTACT RAIL O.B. END APPR. 396+29	TRACTION POWER FEEDER	0	DC-2	2-1/C	#3/0	600V	90°C	125V	DC	0	BATTERY	CONDUIT	NEW 200A ENCLOSED CIRCUIT BREAKER	DC POWER FEEDER	0	
DP-3	5-1/C	1000 MCM	1000V	90°C	700V	DC	0	DC SWGR. UNIT NO.3 TBKR. NO.2	CABLE TRAY & CONDUIT	CONTACT RAIL I.B. END APPR. 396+31	TRACTION POWER FEEDER	0	DC-3	2-1/C	#3/0	600V	90°C	125V	DC	0	NEW 200A ENCLOSED CIRCUIT BREAKER	CONDUIT	DC DISTRIBUTION PANEL DC-56TB	DC POWER FEEDER	0	
DP-4	5-1/C	1000 MCM	1000V	90°C	700V	DC	0	DC SWGR. UNIT NO.4 TBKR. NO.4	CABLE TRAY & CONDUIT	CONTACT RAIL O.B. END APPR. 396+29	TRACTION POWER FEEDER	0	DC-4	2/C	#6	600V	90°C	125V	DC	0	DC DISTRIBUTION PANEL DC-56TB	CABLE TRAY & CONDUIT	DC SWGR. UNIT NO.3 TBKR. NO.2	DC POWER	0	
													DC-5	2/C	#10	600V	90°C	125V	DC	0	DC DISTRIBUTION PANEL DC-56TB	CABLE TRAY & CONDUIT	HMI CABINET	DC POWER	0	
													DC-6	2/C	#12	600V	90°C	125V	DC	0	DC DISTRIBUTION PANEL DC-56TB	CABLE TRAY & CONDUIT	DC CKT. BKR. TEST CABINET	DC POWER	0	
													DC-7	2/C	#12	600V	90°C	125V	DC	0	DC DISTRIBUTION PANEL DC-56TB	CABLE TRAY & CONDUIT	EMERG. TRIP SW. RELAY CABINET	DC POWER	0	
													DC-8	2/C	#12	600V	90°C	125V	DC	0	DC DISTRIBUTION PANEL DC-56TB	CABLE TRAY & CONDUIT	RTU	DC POWER	0	
AN-1	6/C	#14	600V	90°C	125V	DC	3	BATTERY CHARGER	CABLE TRAY & CONDUIT	RTU CABINET	BATT CHARGER FAILURE & FAIL. OF AC SUPPLY	0	DC-9	2/C	#12	600V	90°C	125V	DC	0	DC DISTRIBUTION PANEL DC-56TB	CABLE TRAY & CONDUIT	NETWORK SWITCH	DC POWER	0	
AN-2	NOT USED												DC-10	2/C	#12	600V	90°C	125V	DC	0	DC DISTRIBUTION PANEL DC-56TB	CABLE TRAY & CONDUIT	EMERGENCY LIGHT	DC POWER	0	
AN-3	NOT USED																									
AN-4	NOT USED																									
AN-5	12/C	#14	600V	90°C	125V	DC	2	EMER. TRIP SWITCH RELAY CABINET	CABLE TRAY & CONDUIT	RTU CABINET	ETS FAILURE ANNUNCIATION	0														
													AC-1	4/C	#8	600V	90°C	480V	AC	0	1 GREEN GRD WIRE	EXIST. 480V AC PANEL WTT	CABLE TRAY & CONDUIT	BATTERY CHARGER	BATTERY CHARGER POWER SUPPLY	0
													AC-2	4/C	#8	600V	90°C	480V	AC	0	1 GREEN GRD WIRE	EXIST. 480V AC PANEL WTP	CABLE TRAY & CONDUIT	NEW 15KVA TRANSFORMER	A.C. POWER	0
ET-1	4/C	#10	600V	90°C	125V	DC	2	EMER. TRIP SWITCH RELAY CABINET	CABLE TRAY & CONDUIT	DC SWGR. UNIT NO.1 TBKR. NO.1	CONTACT RAIL EMERGENCY TRIP	0	AC-3	3/C	2/0	600V	90°C	208V	AC	0	1 GREEN GRD WIRE	NEW 15KVA TRANSFORMER	CONDUIT	NEW 120V AC PANEL "LC-5"	A.C. POWER	0
ET-2	4/C	#10	600V	90°C	125V	DC	2	EMER. TRIP SWITCH RELAY CABINET	CABLE TRAY & CONDUIT	DC SWGR. UNIT NO.2 TBKR. NO.3	CONTACT RAIL EMERGENCY TRIP	0	AC-4	3/C	#10	600V	90°C	120V	AC	0	1 GREEN GRD WIRE	NEW 120V AC PANEL "LC-5"	CONDUIT	RECEPTACLES #1	A.C. POWER	0
ET-3	4/C	#10	600V	90°C	125V	DC	2	EMER. TRIP SWITCH RELAY CABINET	CABLE TRAY & CONDUIT	DC SWGR. UNIT NO.3 TBKR. NO.2	CONTACT RAIL EMERGENCY TRIP	0	AC-5	3/C	#12	600V	90°C	120V	AC	0	1 GREEN GRD WIRE	NEW 120V AC PANEL "LC-5"	CONDUIT	NEW ISOLATION TRANSFORMER IT1	IT1 FEED	0
ET-4	4/C	#10	600V	90°C	125V	DC	2	EMER. TRIP SWITCH RELAY CABINET	CABLE TRAY & CONDUIT	DC SWGR. UNIT NO.4 TBKR. NO.4	CONTACT RAIL EMERGENCY TRIP	0	AC-6	2/C	#12	600V	90°C	120V	AC	0		NEW ISOLATION TRANSFORMER IT1	CONDUIT	DC SWGR. UNIT NO.1 TBKR. NO.1	HEATER POWER	0
													AC-7	2/C	#12	600V	90°C	120V	AC	0	1 GREEN GRD WIRE	NEW 120V AC PANEL "LC-5"	CONDUIT	RECEPTACLES #2	A.C. POWER	0
													AC-8	2/C	#12	600V	90°C	120V	AC	0	1 GREEN GRD WIRE	NEW 120V AC PANEL "LC-5"	CONDUIT	SHAFT LIGHTING	A.C. POWER	0
													AC-9	2/C	#12	600V	90°C	120V	AC	0	1 GREEN GRD WIRE	NEW 120V AC PANEL "LC-5"	CONDUIT	RTU	A.C. POWER	0
													AC-10	2/C	#12	600V	90°C	120V	AC	0	1 GREEN GRD WIRE	NEW 120V AC PANEL "LC-5"	CONDUIT	BATTERY CYCLE MONITOR	A.C. POWER	0
SC-1	12/C	#14	600V	90°C	24V	DC	5	DC SWGR. UNIT NO.1 TBKR. NO.1	CABLE TRAY & CONDUIT	SUPERVISORY CONT. TERMINAL BOX	CIRCUIT BREAKER CONTROL & INDICATION	0														
SC-2	12/C	#14	600V	90°C	24V	DC	5	DC SWGR. UNIT NO.2 TBKR. NO.3	CABLE TRAY & CONDUIT	SUPERVISORY CONT. TERMINAL BOX	CIRCUIT BREAKER CONTROL & INDICATION	0	MA-1	1-1/C	#6	2000V	90°C	GRD.	0		DC SWGR. UNIT NO.1 TBKR. NO.1	CONDUIT	STATION GROUND	LIGHTING ARRESTER GROUND	0	
SC-3	12/C	#14	600V	90°C	24V	DC	5	DC SWGR. UNIT NO.3 TBKR. NO.2	CABLE TRAY & CONDUIT	SUPERVISORY CONT. TERMINAL BOX	CIRCUIT BREAKER CONTROL & INDICATION	0	MA-2	1-1/C	#6	2000V	90°C	GRD.	0		DC SWGR. UNIT NO.2 TBKR. NO.3	CONDUIT	STATION GROUND	LIGHTING ARRESTER GROUND	0	
SC-4	12/C	#14	600V	90°C	24V	DC	5	DC SWGR. UNIT NO.4 TBKR. NO.4	CABLE TRAY & CONDUIT	SUPERVISORY CONT. TERMINAL BOX	CIRCUIT BREAKER CONTROL & INDICATION	0	MA-3	1-1/C	#6	2000V	90°C	GRD.	0		DC SWGR. UNIT NO.3 TBKR. NO.2	CONDUIT	STATION GROUND	LIGHTING ARRESTER GROUND	0	
SC-5	NOT USED												MA-4	1-1/C	#6	2000V	90°C	GRD.	0		DC SWGR. UNIT NO.4 TBKR. NO.4	CONDUIT	STATION GROUND	LIGHTING ARRESTER GROUND	0	
SC-6	19/C	#14	600V	90°C	24V	DC	1	RTU CABINET	CABLE TRAY & CONDUIT	SUPERVISORY CONT. TERMINAL BOX	ANNUNCIATION	0	MA-5	-												
													MA-6	2/C	#10	2000V	90°C	GRD.	0		DC SWGR. UNIT NO.2 TBKR. NO.3	CABLE TRAY & CONDUIT	STATION GROUND	GROUND RELAYING	0	
													MA-7	1-1/C	#10	2000V	90°C	700V	0		DC SWGR. UNIT NO.1 TBKR. NO.1	CONDUIT	JUNCTION BOX	NEG. POLARITY REFERENCE	0	
													MA-8	1-1/C	#10	2000V	90°C	700V	0		DC SWGR. UNIT NO.4 TBKR. NO.4	CONDUIT	JUNCTION BOX	NEGATIVE POLARITY REFERENCE	0	

H - A.C. PRIMARY VOLTAGE CABLE
 DP - D.C. POSITIVE POWER CABLE
 DN - D.C. NEGATIVE POWER CABLE
 DD - D.C. UTILITY DRAIN CABLE
 AN - ANNUNCIATOR CABLE
 SC - SUPERVISORY CONTROL CABLE
 ET - EMERGENCY TRIP CABLE
 MT - METERING & INSTRUMENTATION CABLE
 CN - OPERATING CONTROL CABLE
 MA - MISCELLANEOUS CIRCUITS
 AC - A.C. LOW VOLTAGE POWER CIRCUITS
 DC - D.C. CONTROL POWER CIRCUITS
 END APPR - END APPROACH OF CONTACT RAIL
 *** BOLD TEXT INDICATES NEW CABLES
 *** SCREENED TEXT INDICATES EXISTING TO REMAIN CABLES

NOTE:
 CABLES AN-1, AN-5, SC-6, AC-9, AC-10, DC-5, DC-8, AND DC-9 ARE SHOWN ON SCADA DRAWINGS ALSO FOR REFERENCE.

FOR CIRCUIT AC-8, CONNECT SHAFT LIGHTING TO NEW BREAKERS IN NEW PANEL. THE EXISTING BRANCH CIRCUIT WIRING SHALL REMAIN INSTALLED. CONTRACTOR TO MAKE SURE THAT NO NEW SPLICE IN BRANCH CIRCUIT ARE INSTALLED.

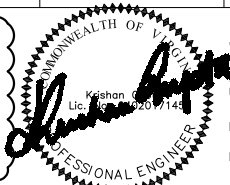

"PROFESSIONAL CERTIFICATION: I HEREBY CERTIFY THAT THESE DOCUMENTS WERE PREPARED OR APPROVED BY ME, AND THAT I AM A DULY LICENSED PROFESSIONAL ENGINEER UNDER THE LAWS OF THE COMMONWEALTH OF VIRGINIA."

LICENSE No. 04020117145
 EXPIRATION DATE: 10/31/2015

-VA Regulations 18VAC10-20-760

WASHINGTON METROPOLITAN AREA TRANSIT AUTHORITY
 DEPARTMENT OF TRANSIT INFRASTRUCTURE AND ENGINEERING SERVICES
 CENI - POWER SYSTEMS ENGINEERING

REVISION SUBMITTED: _____ DATE: _____
 APPROVED: _____ DATE: _____
 DEPUTY CHIEF ENGINEER


SIX (6) TIE BREAKER STATIONS UPGRADES ORANGE AND BLUE LINES DC, MD AND VA
 G02TB1 - 56TH PLACE TIE BREAKER STATION CONDUIT AND CABLE SCHEDULE

CONTRACT NO. FQ15237
 SCALE NONE
 DRAWING NO. G02TB1-TB-300
 SHEET NO. 49 OF 60

DESIGNED			DRAWN			CHECKED		
JAJ	4/4/15	DATE	JAJ	5/20/15	DATE	PK	6/1/15	DATE

REFERENCE DRAWINGS		REVISIONS	
NUMBER	TITLE	DATE	DESCRIPTION
		11/2/15	AMENDMENT NO. 1

Drawing File: H:\WMATA PROJECTS\FQ15237\DRG\TBS\G02TB1 - TB-401.DWG
 Plotted by: E013941 Date: Fri, 30 Oct 2015 Time: 10:47:34 am
 Xrefs: N:\ROBINSON-ELECT-MECH\ELEC-MECH-PWR AutoCAD Folder\WMATA CAD TEMPLATE\Library\GUPTA SIGNATURE.tif

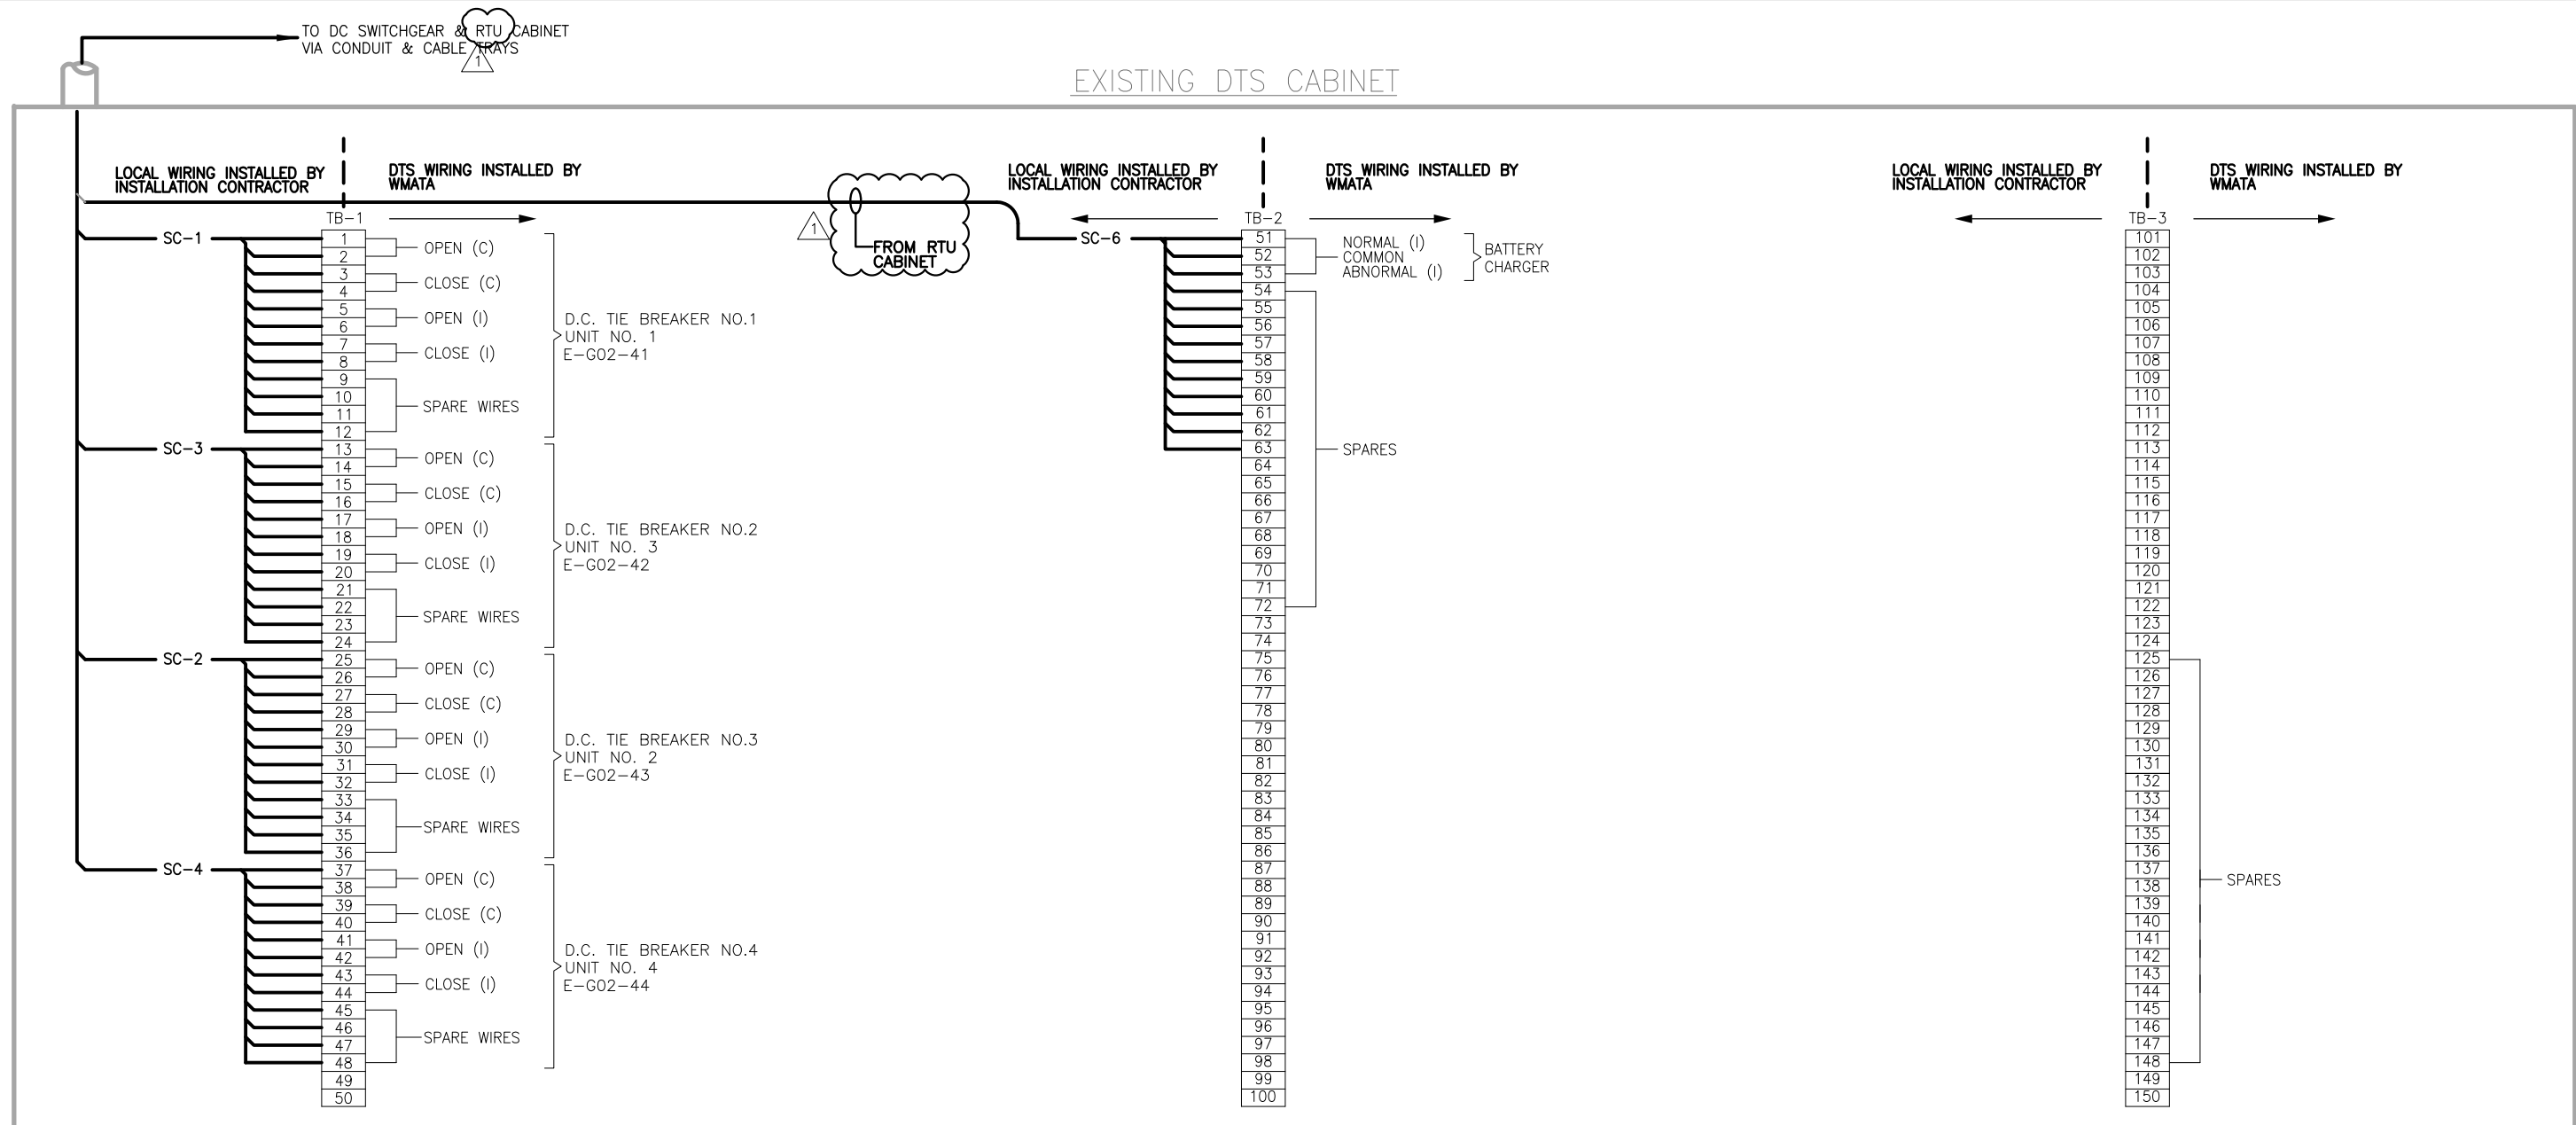

G02TB1 TIE BREAKER STATION

NOTES:

1. WIRING & TERMINATION FOR BATTERY CHARGER IS NOT REQUIRED WHEN D.C. POWER IS SUPPLIED FROM PASSENGER STATION. TERMINALS NOT USED WILL BECOME SPARES WITH JUMPER AT TERMINALS 76-75.
2. WHEN TWO TIE BREAKER STATIONS ARE IN THE SAME RTU CONTROL AREA, THE SECOND TIE BREAKER STATION WILL USE A DIFFERENT SERIES OF BREAKER NUMBERS. SEE TABLE AT LEFT.
3. FOR SECOND TIE BREAKER STATION, USE NUMERAL 6 INSTEAD OF 4.
4. SIX ADDITIONAL WIRES ARE BROUGHT TO DTS CABINET, THREE FOR ETS TRIP AND THREE SPARES. WMATA WILL CONNECT THEM TO TERMINAL BLOCKS AS REQUIRED.

LEGEND:
 (I) — DENOTES INDICATION
 (C) — DENOTES CONTROL
 * — SEE NOTE 2

FUNCTION	BRK NO.	1 ST TBS BRK NO.	2 ND TBS BRK NO.	YARD AREA INTERFACE BRK NO.
DC TIE BRK NO.	1	41	61	81
	2	42	62	82
	3	43	63	83
	4	44	64	84
	5	45	65	85
	6	46	66	86
	7	47	67	87
	8	48	68	88



"PROFESSIONAL CERTIFICATION: I HEREBY CERTIFY THAT THESE DOCUMENTS WERE PREPARED OR APPROVED BY ME, AND THAT I AM A DULY LICENSED PROFESSIONAL ENGINEER UNDER THE LAWS OF THE COMMONWEALTH OF VIRGINIA."
 LICENSE No. 04020117145
 EXPIRATION DATE: 10/31/2015

-VA Regulations 18VAC10-20-760

DESIGNED			DRAWN			CHECKED		
JAJ	4/4/15	DATE	JAJ	5/20/15	DATE	PK	6/1/15	DATE



REFERENCE DRAWINGS				REVISIONS			
NUMBER	TITLE	DATE	NUM	DESCRIPTION	DATE	NUM	DESCRIPTION
		11/2/15	Δ	AMENDMENT NO. 1			

WASHINGTON METROPOLITAN AREA TRANSIT AUTHORITY
 DEPARTMENT OF TRANSIT INFRASTRUCTURE AND ENGINEERING SERVICES
 CENI - POWER SYSTEMS ENGINEERING

REVISION SUBMITTED _____ DATE _____ APPROVED _____ DATE _____
 DEPUTY CHIEF ENGINEER

SIX (6) TIE BREAKER STATIONS UPGRADES ORANGE AND BLUE LINES DC, MD AND VA		G02TB1 - 56TH PLACE TIE BREAKER STATION SUPERVISORY AND CONTROL DIAGRAM - NEW	
CONTRACT NO. FQ15237	SCALE NONE	DRAWING NO. G02TB1-TB-401	SHEET NO. 51 OF 60

Drawing File: H:\WMATA PROJECTS\FQ15237\DRG\TBS\G02TB1 - 56TH PLACE TBS\G02TB1 - TB-500.DWG
 Plotted by: E013941 Date: Fri, 30 Oct 2015 Time: 10:47:46 am
 Xrefs: N:\ROBINSON-ELECT-MECH\ELEC-MECH-PWR AutoCAD Folder\WMATA CAD TEMPLATE\Library\CUPTA SIGNATURE.tif

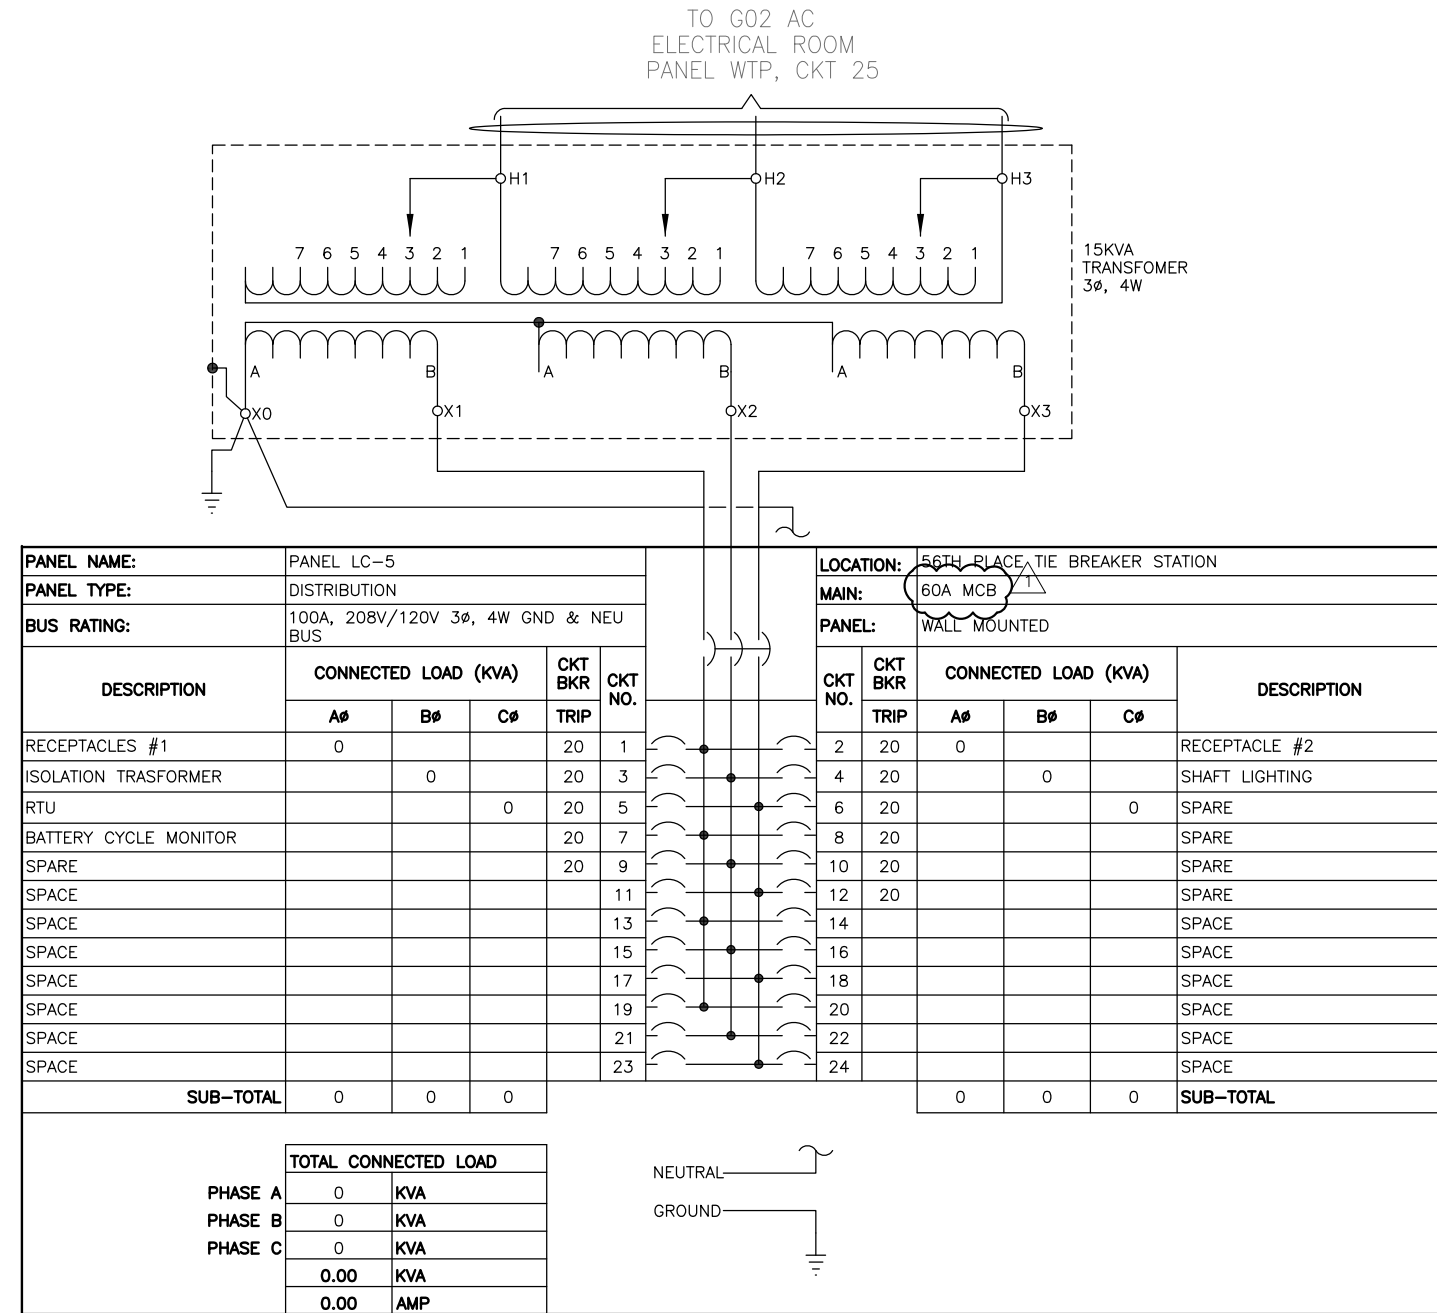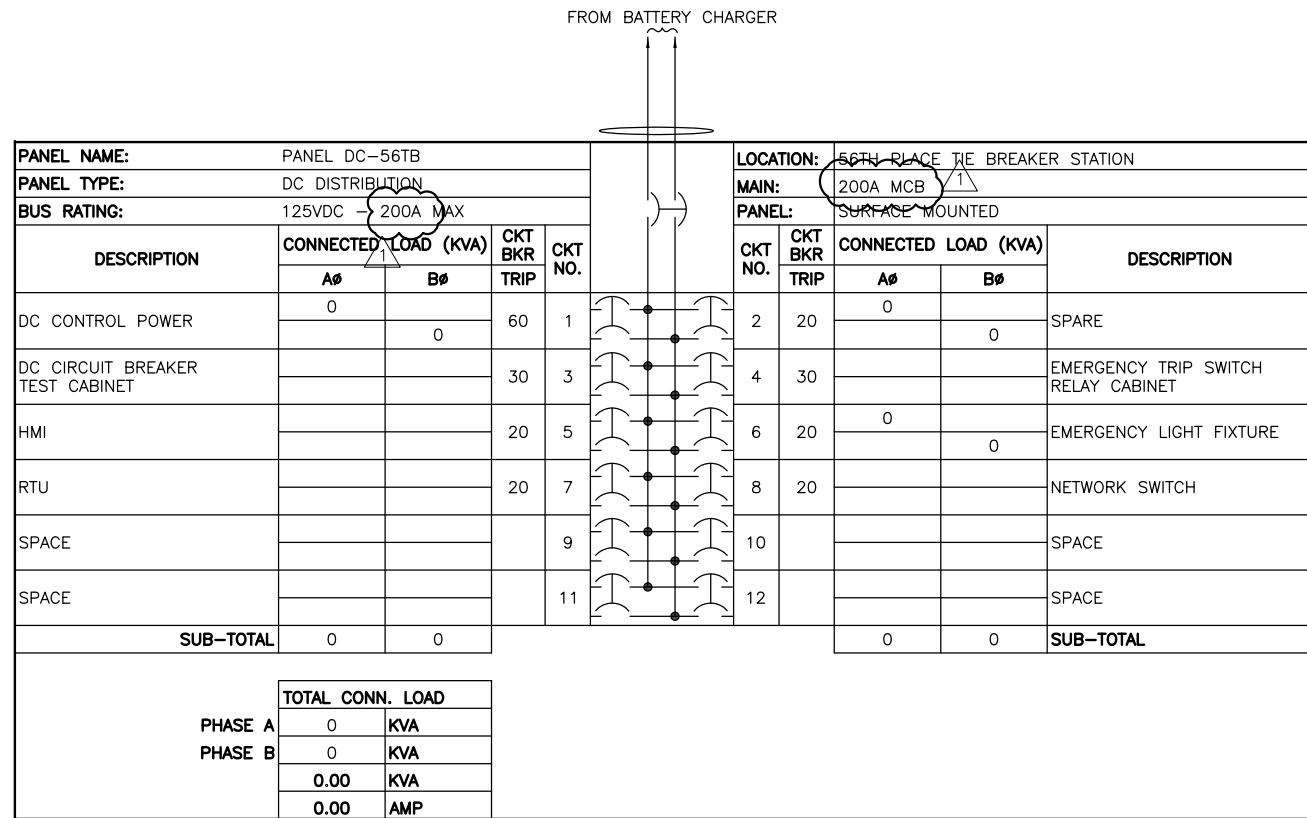

"PROFESSIONAL CERTIFICATION: I HEREBY CERTIFY THAT THESE DOCUMENTS WERE PREPARED OR APPROVED BY ME, AND THAT I AM A DULY LICENSED PROFESSIONAL ENGINEER UNDER THE LAWS OF THE COMMONWEALTH OF VIRGINIA."
 LICENSE No. 04020117145
 EXPIRATION DATE: 10/31/2015
 -VA Regulations 18VAC10-20-760

WASHINGTON METROPOLITAN AREA TRANSIT AUTHORITY
 DEPARTMENT OF TRANSIT INFRASTRUCTURE AND ENGINEERING SERVICES
 CENI - POWER SYSTEMS ENGINEERING

REVISION SUBMITTED: _____ DATE: _____ APPROVED: _____ DATE: _____
 DEPUTY CHIEF ENGINEER


**SIX (6) TIE BREAKER STATIONS UPGRADES
 ORANGE AND BLUE LINES DC, MD AND VA**
 G02TB1 - 56TH PLACE TIE BREAKER STATION
 PANELBOARD SCHEDULES

CONTRACT NO. FQ15237	SCALE NONE	DRAWING NO. G02TB1-TB-500	SHEET NO. 52 OF 60
-------------------------	---------------	------------------------------	-----------------------

DESIGNED			DRAWN			CHECKED		
JAJ	4/4/15	DATE	JAJ	5/20/15	DATE	PK	6/1/15	DATE

REFERENCE DRAWINGS		REVISIONS	
NUMBER	TITLE	DATE	DESCRIPTION
		11/2/15	AMENDMENT NO. 1

Drawing File: H:\WMATA PROJECTS\FQ15237\DRG\TBS\G02TB2 - 67TH AVE TBS\G02TB2-TB-201.DWG
 Plotted by: E013941 Date: Fri, 30 Oct 2015 Time: 10:47:51 am
 Xrefs: .\..\..\DES\ARCH\G02TB2 - 67TH AVE TBS FLOOR PLAN.dwg ; .\..\..\DES\TBS\G02TB2 - 67TH AVE TBS DESIGN FILE.dwg
 Images: .\..\ROBINSON-ELECT-MECH-ELEC-MECH-PWR AutoCAD Folder\WMATA CAD TEMPLATE\Library\GUPTA SIGNATURE.tif

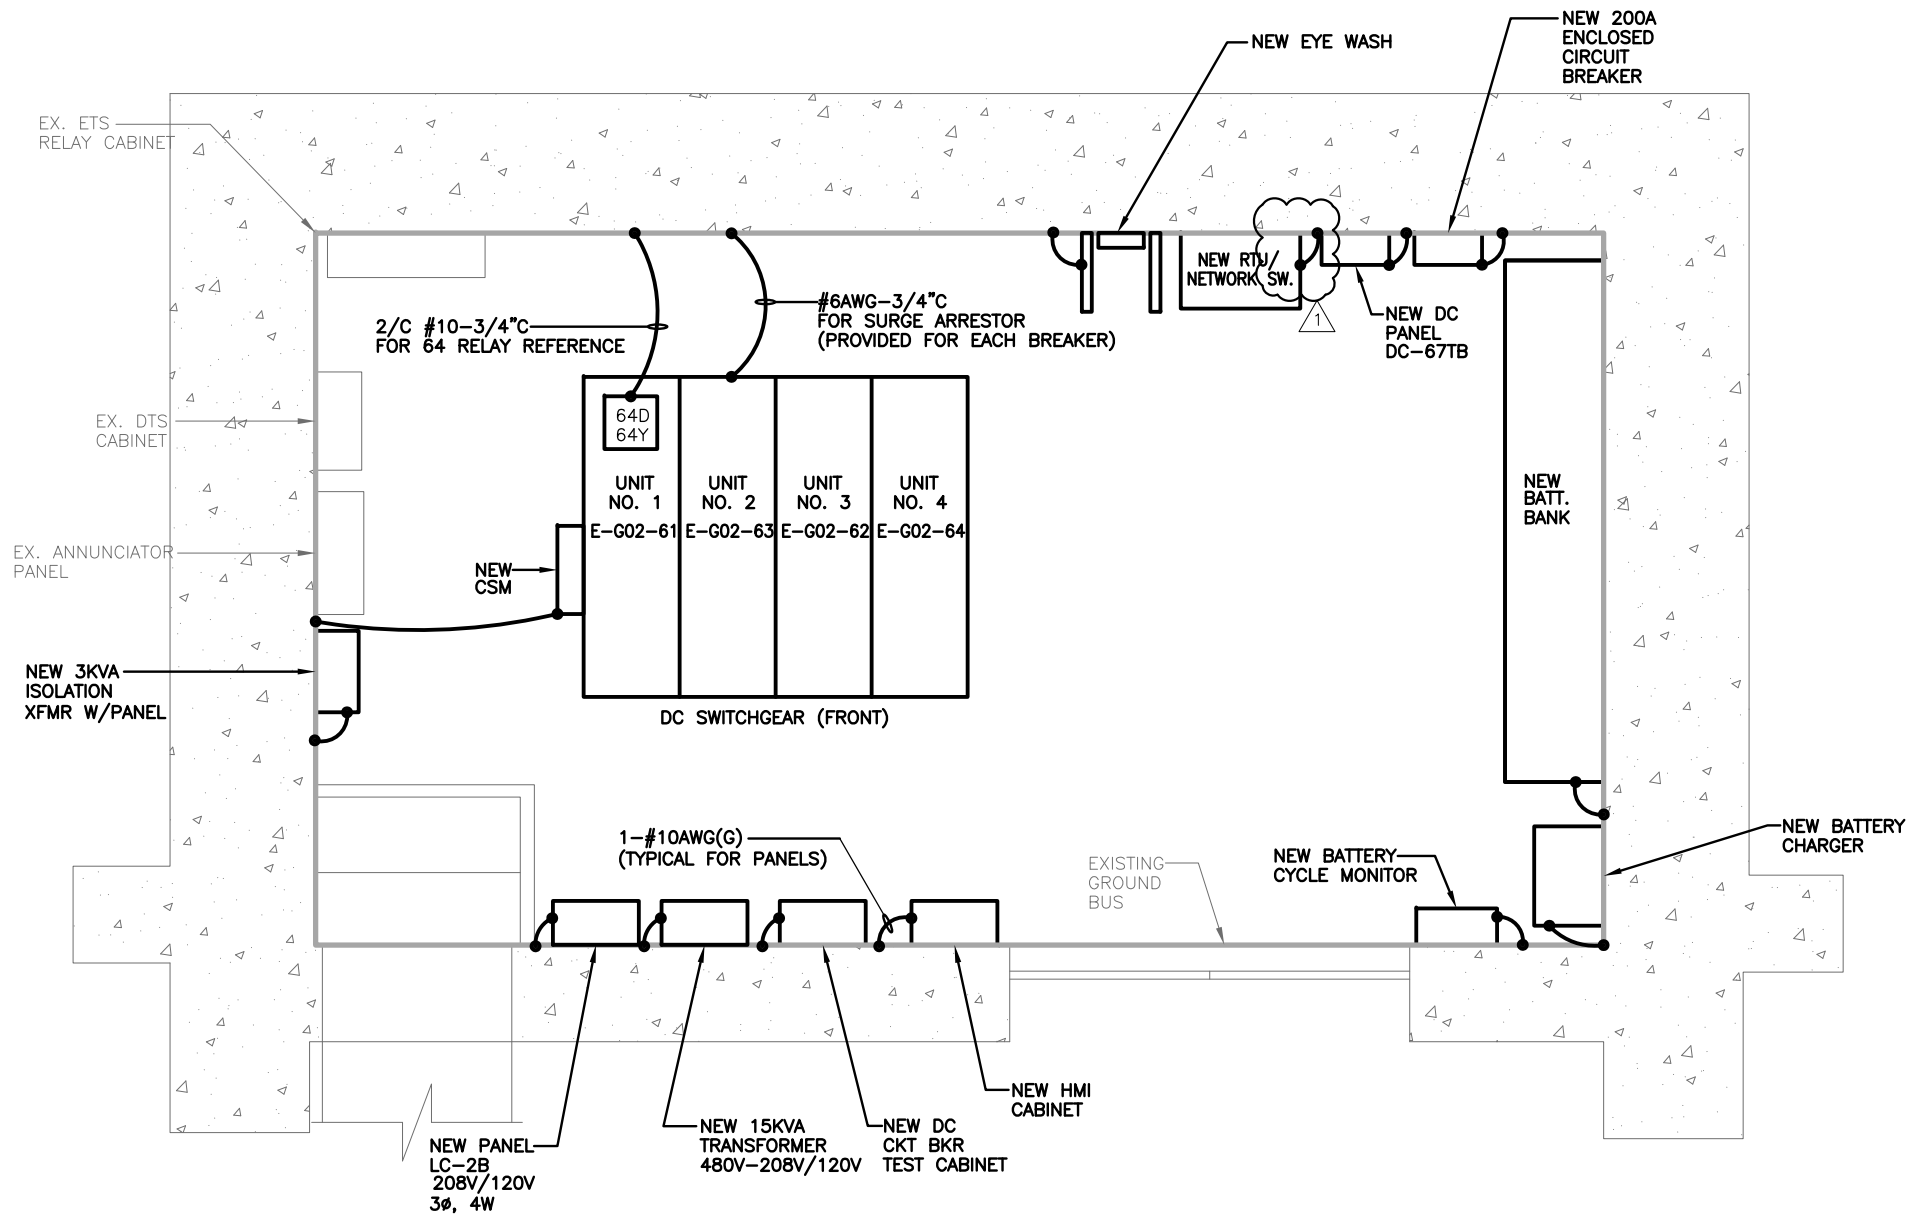

- NOTES:**
- DRAWING SHOWS GROUNDING REQUIREMENTS FOR NEW OR REPLACEMENT EQUIPMENT. CONTRACTOR DOES NOT NEED TO MODIFY GROUNDING OF EXISTING EQUIPMENT THAT IS NOT BEING REPLACED.
 - ALL GROUND CONDUCTORS RUN BETWEEN EQUIPMENT AND SUBSTATION GROUND BUS SHALL BE 1-#6 BARE CU CONDUCTOR UNLESS OTHERWISE SHOWN.
 - THE NEW DTR MOUNTED ON THE DC SWITCHGEAR (NOT SHOWN ON THIS DRAWING) SHALL BE GROUNDED TO THE GROUND BUS BAR WITH #10AWG.

A | **EQUIPMENT GROUNDING PLAN - NEW**
 G02TB2-TB-201 | 67TH AVE. TBS | SCALE: 1/2"=1'-0"

"PROFESSIONAL CERTIFICATION: I HEREBY CERTIFY THAT THESE DOCUMENTS WERE PREPARED OR APPROVED BY ME, AND THAT I AM A DULY LICENSED PROFESSIONAL ENGINEER UNDER THE LAWS OF THE COMMONWEALTH OF VIRGINIA."
 LICENSE No. 04020117145
 EXPIRATION DATE: 10/31/2015
- VA Regulations 18VAC10-20-760

DESIGNED			DRAWN			CHECKED		
JAJ	4/4/15	DATE	JAJ	5/20/15	DATE	PK	6/1/15	DATE

REFERENCE DRAWINGS		REVISIONS		
NUMBER	TITLE	DATE	NUM	DESCRIPTION
		11/2/15	Δ	AMENDMENT NO. 1

WASHINGTON METROPOLITAN AREA TRANSIT AUTHORITY
 DEPARTMENT OF TRANSIT INFRASTRUCTURE AND ENGINEERING SERVICES
 CENI - POWER SYSTEMS ENGINEERING

REVISION SUBMITTED: _____ DATE: _____
 APPROVED: _____ DATE: _____
DEPUTY CHIEF ENGINEER

SIX (6) TIE BREAKER STATIONS UPGRADES ORANGE AND BLUE LINES DC, MD AND VA G02TB2 - 67TH AVE. TIE BREAKER STATION EQUIPMENT GROUNDING PLAN - NEW		CONTRACT NO. FQ15237	SCALE AS NOTED	DRAWING NO. G02TB2-TB-201	SHEET NO. 55 OF 60
--	--	-------------------------	-------------------	------------------------------	-----------------------


Drawing File: H:\WMATA PROJECTS\F015237\DRG\TBS\G02TB2 - 67TH AVE TBS\G02TB2-TB-300.DWG
 Plotted by: E013941 Date: Fri, 30 Oct 2015 Time: 12:13:48 pm
 Xrefs: N:\ROBINSON-ELECT-MECH-ELEC-MECH-PWR AutoCAD Folder\WMATA CAD TEMPLATE\Library\GUPTA SIGNATURE.tif

CABLE					CIRCUIT			ROUTING				CABLE					CIRCUIT			ROUTING						
NUMBER	CONSTRUCT.	SIZE AWG.	INSULATION		VOLTAGE	A.C. OR D.C.	SPARE COND.	FROM	VIA	TO	FOR	REV. NO.	NUMBER	CONSTRUCT.	SIZE AWG.	INSULATION		VOLTAGE	A.C. OR D.C.	SPARE COND.	FROM	VIA	TO	FOR	REV. NO.	
			VOLTAGE	TYPE												VOLTAGE	TYPE									
DP-1	4-1/C	1000 MCM	1000V	90°C	700V	DC	0	DC SWGR. UNIT NO.1 TBKR. NO.1	CABLE TRAY & CONDUIT	CONTACT RAIL O.B. END APPR. 449+23	TRACTION POWER FEEDER	0	DC-5	2/C	#10	600V	90°C	125V	DC	0	DC DISTRIBUTION PANEL DC-56TB	CABLE TRAY & CONDUIT	HMI CABINET	DC POWER	0	
DP-2	4-1/C	1000 MCM	1000V	90°C	700V	DC	0	DC SWGR. UNIT NO.2 TBKR. NO.3	CABLE TRAY & CONDUIT	CONTACT RAIL O.B. END APPR. 448+67	TRACTION POWER FEEDER	0	DC-6	2/C	#12	600V	90°C	125V	DC	0	DC DISTRIBUTION PANEL DC-67TB	CABLE TRAY & CONDUIT	DC CKT. BKR. TEST CABINET	DC POWER	0	
DP-3	4-1/C	1000 MCM	1000V	90°C	700V	DC	0	DC SWGR. UNIT NO.3 TBKR. NO.2	CABLE TRAY & CONDUIT	CONTACT RAIL I.B. END APPR. 449+23	TRACTION POWER FEEDER	0	DC-7	2/C	#12	600V	90°C	125V	DC	0	DC DISTRIBUTION PANEL DC-67TB	CABLE TRAY & CONDUIT	EMERG. TRIP SW. RELAY CABINET	DC POWER	0	
DP-4	4-1/C	1000 MCM	1000V	90°C	700V	DC	0	DC SWGR. UNIT NO.4 TBKR. NO.4	CABLE TRAY & CONDUIT	CONTACT RAIL O.B. END APPR. 448+67	TRACTION POWER FEEDER	0	DC-8	2/C	#12	600V	90°C	125V	DC	0	DC DISTRIBUTION PANEL DC-67TB	CONDUIT	RTU	DC POWER	0	
												0	DC-9	2/C	#10	600V	90°C	125V	DC		DC DISTRIBUTION PANEL DC-67TB	CABLE TRAY & CONDUIT	NETWORK SWITCH	DC POWER	0	
												0	DC-10	2/C	#10	600V	90°C	125V	DC		DC DISTRIBUTION PANEL DC-67TB	CABLE TRAY & CONDUIT	EMERGENCY LIGHT	DC POWER	0	
AN-1	6/C	#14	600V	90°C	125V	DC	3	BATTERY CHARGER	CABLE TRAY & CONDUIT	RTU CABINET	BATT. CHARGER FAIL	0	AC-1	3-1/C	#12	600V	90°C	277V	AC	0	1 GREEN GRD WIRE	EXIST. 480V AC PANEL LC-2	CONDUIT	LIGHTING	TBS LIGHTING	0
AN-2	NOT USED												AC-2	4/C	#8	600V	90°C	480V	AC	0	1 GREEN GRD WIRE	EXIST. 480V AC PANEL LC-2	CABLE TRAY & CONDUIT	BATTERY CHARGER	BATTERY CHARGER POWER SUPPLY	0
AN-3	NOT USED												AC-3	4/C	#10	600V	90°C	480V	AC	0	1 GREEN GRD WIRE	EXIST. 480V AC PANEL LC-2	CABLE TRAY & CONDUIT	NEW 15KVA TRANSFORMER	A.C. POWER	0
AN-4	NOT USED												AC-4	4/C	#6	600V	90°C	480V	AC	0	1 GREEN GRD WIRE	NEW 15KVA TRANSFORMER	CONDUIT	NEW AC 20/V120V PANEL "LC-2B"	A.C. POWER	0
AN-5	12/C	#14	600V	90°C	125V	DC	2	EMER. TRIP SWITCH RELAY CABINET	CONDUIT	RTU CABINET	ETS FAILURE ANNUNCIATION		AC-5	3/C	#12	600V	90°C	120V	AC	0	1 GREEN GRD WIRE	NEW AC 20/V120V PANEL "LC-2B"	CONDUIT	NEW ISOLATION TRANSFORMER IT1	A.C. POWER	0
													AC-6	2/C	#12	600V	90°C	120V	AC	0		NEW ISOLATION TRANSFORMER IT1	CABLE TRAY & CONDUIT	DC SWGR. UNIT NO.3 TBKR. NO.2	HTR POWER SUPPLY	0
													AC-7	2/C	#12	600V	90°C	120V	AC	0	1 GREEN GRD WIRE	NEW AC 20/V120V PANEL "LC-2B"	CONDUIT	RTU	A.C. POWER	0
													AC-8	2/C	#12	600V	90°C	120V	AC	0	1 GREEN GRD WIRE	NEW AC 20/V120V PANEL "LC-2B"	CONDUIT	BATTERY CYCLE MONITOR	A.C. POWER	0
SC-1	12/C	#14	600V	90°C	24V	DC	5	DC SWGR. UNIT NO.1 TBKR. NO.1	CABLE TRAY & CONDUIT	SUPERVISORY CONT. TERMINAL BOX	CIRCUIT BREAKER CONTROL & INDICATION	0														
SC-2	12/C	#14	600V	90°C	24V	DC	5	DC SWGR. UNIT NO.2 TBKR. NO.3	CABLE TRAY & CONDUIT	SUPERVISORY CONT. TERMINAL BOX	CIRCUIT BREAKER CONTROL & INDICATION	0														
SC-3	12/C	#14	600V	90°C	24V	DC	5	DC SWGR. UNIT NO.3 TBKR. NO.2	CABLE TRAY & CONDUIT	SUPERVISORY CONT. TERMINAL BOX	CIRCUIT BREAKER CONTROL & INDICATION	0	ET-1	4/C	#10	600V	90°C	125V	DC	2	EMER. TRIP SWITCH RELAY CABINET	CABLE TRAY & CONDUIT	DC SWGR. UNIT NO.1 TBKR. NO.1	CONTACT RAIL EMERGENCY TRIP	0	
SC-4	12/C	#14	600V	90°C	24V	DC	5	DC SWGR. UNIT NO.4 TBKR. NO.4	CABLE TRAY & CONDUIT	SUPERVISORY CONT. TERMINAL BOX	CIRCUIT BREAKER CONTROL & INDICATION	0	ET-2	4/C	#10	600V	90°C	125V	DC	2	EMER. TRIP SWITCH RELAY CABINET	CABLE TRAY & CONDUIT	DC SWGR. UNIT NO.2 TBKR. NO.3	CONTACT RAIL EMERGENCY TRIP	0	
SC-5	NOT USED												ET-3	4/C	#10	600V	90°C	125V	DC	2	EMER. TRIP SWITCH RELAY CABINET	CABLE TRAY & CONDUIT	DC SWGR. UNIT NO.3 TBKR. NO.2	CONTACT RAIL EMERGENCY TRIP	0	
SC-6	19/C	#14	600V	90°C	24V	DC	1	RTU CABINET	CABLE TRAY & CONDUIT	SUPERVISORY CONT. TERMINAL BOX	ANNUNCIATION	0	ET-4	4/C	#10	600V	90°C	125V	DC	2	EMER. TRIP SWITCH RELAY CABINET	CABLE TRAY & CONDUIT	DC SWGR. UNIT NO.4 TBKR. NO.4	CONTACT RAIL EMERGENCY TRIP	0	
													MA-1	1-1/C	#6	2000V	90°C	GRD.	0		DC SWGR. UNIT NO.1 TBKR. NO.1	CONDUIT	STATION GROUND	LIGHTING ARRESTER GROUND	0	
													MA-2	1-1/C	#6	2000V	90°C	GRD.	0		DC SWGR. UNIT NO.2	CONDUIT	STATION GROUND	LIGHTING ARRESTER GROUND	0	
													MA-3	1-1/C	#6	2000V	90°C	GRD.	0		DC SWGR. UNIT NO.3	CONDUIT	STATION GROUND	LIGHTING ARRESTER GROUND	0	
													MA-4	1-1/C	#6	2000V	90°C	GRD.	0		DC SWGR. UNIT NO.4 TBKR. NO.4	CONDUIT	STATION GROUND	LIGHTING ARRESTER GROUND	0	
DC-1	2-1/C	#4	600V	90°C	125V	DC	0	BATTERY CHARGER	CONDUIT	NEW 200A ENCLOSED CIRCUIT BREAKER	BATTERY CHARGING DC FEED	0	MA-5	NOT USED												
DC-2	2-1/C	#3/0	600V	90°C	125V	DC	0	BATTERY	CONDUIT	NEW 200A ENCLOSED CIRCUIT BREAKER	DC POWER FEEDER	0	MA-6	2/C	#10	2000V	90°C	GRD.	0		DC SWGR. UNIT NO.2 TBKR. NO.3	CABLE TRAY & CONDUIT	STATION GROUND	GROUND RELAYING	0	
DC-3	2-1/C	#3/0	600V	90°C	125V	DC	0	NEW 200A ENCLOSED CIRCUIT BREAKER	CONDUIT	DC DISTRIBUTION PANEL DC-67TB	DC POWER FEEDER	0	MA-7	1-1/C	#10	2000V	90°C	700V	0		DC SWGR. UNIT NO.5 TBKR. NO.2	CONDUIT	JUNCTION BOX	NEG. POLARITY REFERENCE	0	
DC-4	2/C	#6	600V	90°C	125V	DC	0	DC DISTRIBUTION PANEL DC-67TB	CABLE TRAY & CONDUIT	DC SWGR. UNIT NO.3 TBKR. NO.2	DC POWER	0	MA-8	1-1/C	#10	2000V	90°C	700V	0		DC SWGR. UNIT NO.3 TBKR. NO.2	CONDUIT	JUNCTION BOX	NEGATIVE POLARITY REFERENCE	0	

H - A.C. PRIMARY VOLTAGE CABLE
 DP - D.C. POSITIVE POWER CABLE
 DN - D.C. NEGATIVE POWER CABLE
 DD - D.C. UTILITY DRAIN CABLE
 AN - ANNUNCIATOR CABLE
 SC - SUPERVISORY CONTROL CABLE
 ET - EMERGENCY TRIP CABLE
 MT - METERING & INSTRUMENTATION CABLE
 CN - OPERATING CONTROL CABLE
 MA - MISCELLANEOUS CIRCUITS
 AC - A.C. LOW VOLTAGE POWER CIRCUITS
 DC - D.C. CONTROL POWER CIRCUITS

END APPR - END APPROACH OF CONTACT RAIL
 *** BOLD TEXT INDICATES NEW CABLES
 *** SCREENED TEXT INDICATES EXISTING TO REMAIN CABLES

NOTE:
 CABLES AN-1, AN-5, AC-7, AC-8, DC-5, DC-8, SC-6 AND DC-9 ARE SHOWN ON SCADA DRAWINGS ALSO FOR REFERENCE

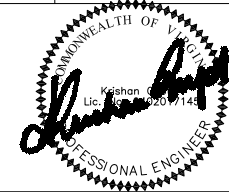

"PROFESSIONAL CERTIFICATION: I HEREBY CERTIFY THAT THESE DOCUMENTS WERE PREPARED OR APPROVED BY ME, AND THAT I AM A DULY LICENSED PROFESSIONAL ENGINEER UNDER THE LAWS OF THE COMMONWEALTH OF VIRGINIA."
 LICENSE No. 04020117145
 EXPIRATION DATE: 10/31/2015
 -VA Regulations 18VAC10-20-760

DESIGNED			DRAWN			CHECKED		
JAJ	4/4/15	DATE	JAJ	5/20/15	DATE	PK	6/1/15	DATE


REFERENCE DRAWINGS		REVISIONS	
NUMBER	TITLE	DATE	DESCRIPTION
		11/2/15	AMENDMENT NO. 1

M WASHINGTON METROPOLITAN AREA TRANSIT AUTHORITY
 DEPARTMENT OF TRANSIT INFRASTRUCTURE AND ENGINEERING SERVICES
 CENI - POWER SYSTEMS ENGINEERING

REVISION SUBMITTED _____ DATE _____
 APPROVED _____ DATE _____
 DEPUTY CHIEF ENGINEER

SIX (6) TIE BREAKER STATIONS UPGRADES ORANGE AND BLUE LINES DC, MD AND VA	
G02TB2 - 67TH AVE. TIE BREAKER STATION CONDUIT AND CABLE SCHEDULE	
CONTRACT NO. FQ15237	SCALE NONE
DRAWING NO. G02TB2-TB-300	SHEET NO. 57 OF 60

Drawing File: H:\WMATA PROJECTS\FQ15237\DRG\TBS\G02TB2 - 67TH AVE TBS\G02TB2-TB-401.DWG
 Plotted by: E013941 Date: Fri, 30 Oct 2015 Time: 10:48:10 am
 Xrefs: N:\ROBINSON-ELECT-MECH\ELEC-MECH-PWR AutoCAD Folder\WMATA CAD TEMPLATE\Library\GUPTA SIGNATURE.tif

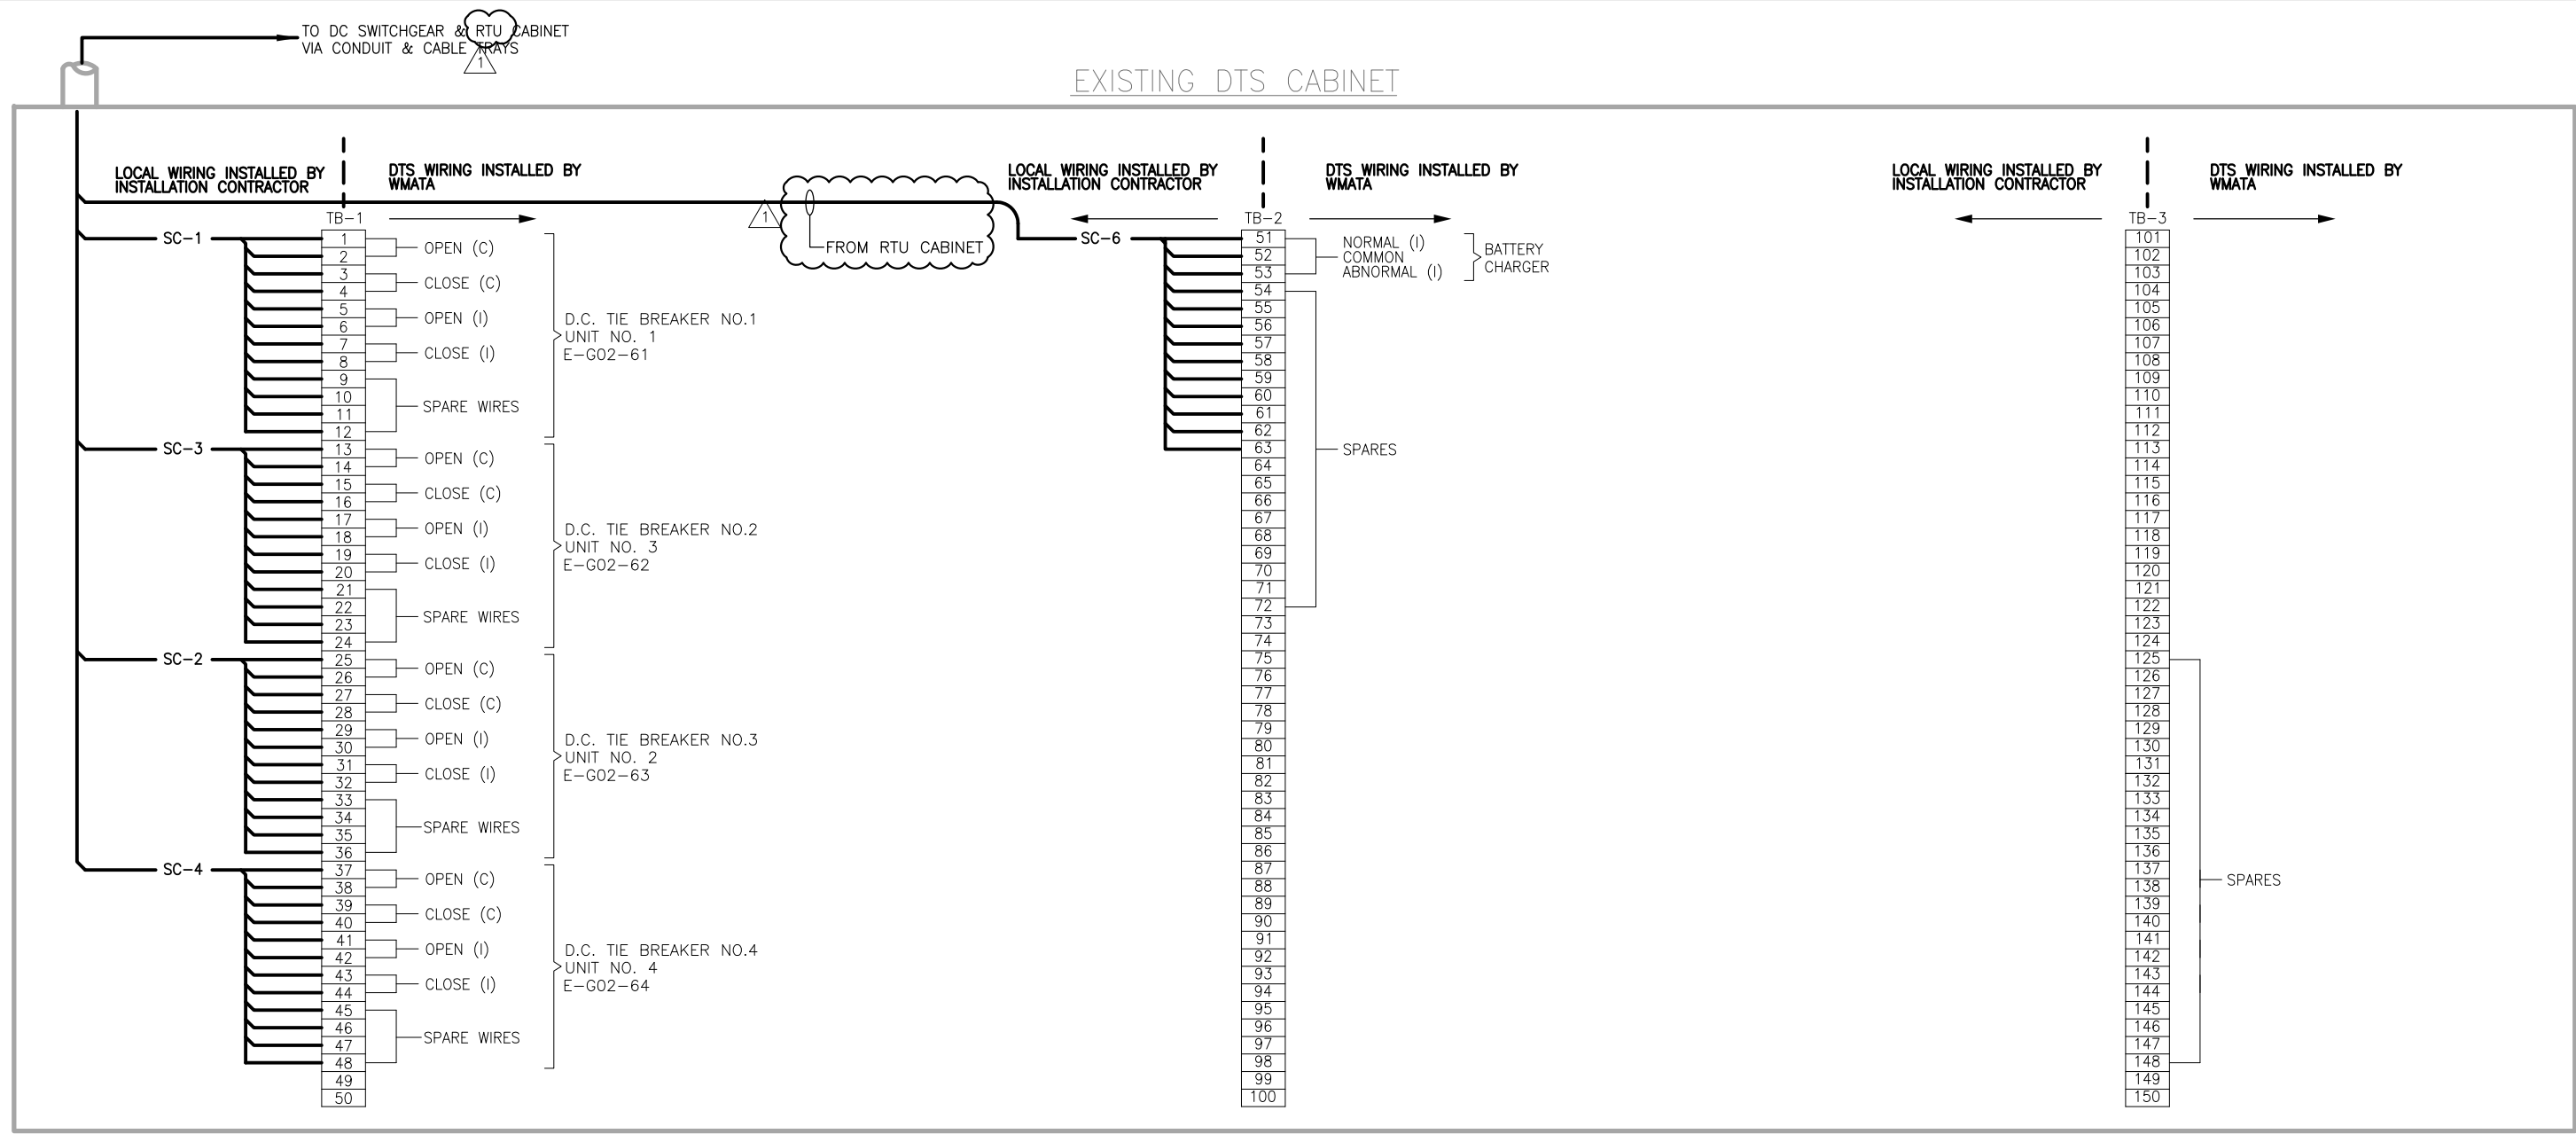

G02TB2 TIE BREAKER STATION

NOTES:

1. WIRING & TERMINATION FOR BATTERY CHARGER IS NOT REQUIRED WHEN D.C. POWER IS SUPPLIED FROM PASSENGER STATION. TERMINALS NOT USED WILL BECOME SPARES WITH JUMPER AT TERMINALS 76-75.
2. WHEN TWO TIE BREAKER STATIONS ARE IN THE SAME RTU CONTROL AREA, THE SECOND TIE BREAKER STATION WILL USE A DIFFERENT SERIES OF BREAKER NUMBERS. SEE TABLE AT LEFT.
3. FOR SECOND TIE BREAKER STATION, USE NUMERAL 6 INSTEAD OF 4.
4. SIX ADDITIONAL WIRES ARE BROUGHT TO DTS CABINET, THREE FOR ETS TRIP AND THREE SPARES. WMATA WILL CONNECT THEM TO TERMINAL BLOCKS AS REQUIRED.

LEGEND:
 (I) — DENOTES INDICATION
 (C) — DENOTES CONTROL
 * — SEE NOTE 2


FUNCTION	BRK NO.	1 ST TBS BRK NO.	2 ND TBS BRK NO.	YARD AREA INTERFACE BRK NO.
DC TIE BRK NO.	1	41	61	81
	2	42	62	82
	3	43	63	83
	4	44	64	84
	5	45	65	85
	6	46	66	86
	7	47	67	87
	8	48	68	88

"PROFESSIONAL CERTIFICATION: I HEREBY CERTIFY THAT THESE DOCUMENTS WERE PREPARED OR APPROVED BY ME, AND THAT I AM A DULY LICENSED PROFESSIONAL ENGINEER UNDER THE LAWS OF THE COMMONWEALTH OF VIRGINIA."
 LICENSE No. 04020117145
 EXPIRATION DATE: 10/31/2015
-VA Regulations 18VAC10-20-760

DESIGNED: JAJ 4/4/15 DATE DRAWN: JAJ 5/20/15 DATE CHECKED: PK 6/1/15 DATE	REFERENCE DRAWINGS NUMBER TITLE DATE NUM DESCRIPTION 11/2/15 Δ AMENDMENT NO. 1	WASHINGTON METROPOLITAN AREA TRANSIT AUTHORITY DEPARTMENT OF TRANSIT INFRASTRUCTURE AND ENGINEERING SERVICES CENI - POWER SYSTEMS ENGINEERING	SIX (6) TIE BREAKER STATIONS UPGRADES ORANGE AND BLUE LINES DC, MD AND VA G02TB2 - 67TH AVE. TIE BREAKER STATION SUPERVISORY AND CONTROL DIAGRAM - NEW
		REVISION SUBMITTED DATE APPROVED DATE DEPUTY CHIEF ENGINEER	CONTRACT NO. FQ15237 SCALE NONE DRAWING NO. G02TB2-TB-401 SHEET NO. 59 OF 60

Drawing File: H:\WMATA PROJECTS\FQ15237\DRG\TBS\G02TB2 - 67TH AVE TBS\G02TB2-TB-500.DWG
 Plotted by: E013941 Date: Fri, 30 Oct 2015 Time: 10:48:21 am
 Xrefs: N:\ROBINSON-ELECT-MECH\ELEC-MECH-PWR AutoCAD Folder\WMATA CAD TEMPLATE\Library\CUPTA SIGNATURE.tif

PANEL NAME: PANEL DC-67TB		LOCATION: 67TH AVE. TIE BREAKER STATION							
PANEL TYPE: DC DISTRIBUTION		MAIN: 200A MCB							
BUS RATING: 125VDC - (200A) MAX		PANEL: SURFACE MOUNTED							
DESCRIPTION	CONNECTED LOAD (KVA)		CKT BKR TRIP	CKT NO.	CKT NO.	CKT BKR TRIP	CONNECTED LOAD (KVA)		DESCRIPTION
	AØ	BØ					AØ	BØ	
DC CONTROL POWER	0	0	60	1	2	20	0	0	SPARE
DC CIRCUIT BREAKER TEST CABINET			30	3	4	30			EMERGENCY TRIP SWITCH RELAY CABINET
HMI			20	5	6	20	0	0	EMERGENCY LIGHT FIXTURE
RTU			20	7	8	20			NETWORK SWITCH
SPACE				9	10				SPACE
SPACE				11	12				SPACE
SUB-TOTAL		0	0				0	0	SUB-TOTAL
		TOTAL CONN. LOAD							
PHASE A	0	KVA							
PHASE B	0	KVA							
	0.00	KVA							
	0.00	AMP							

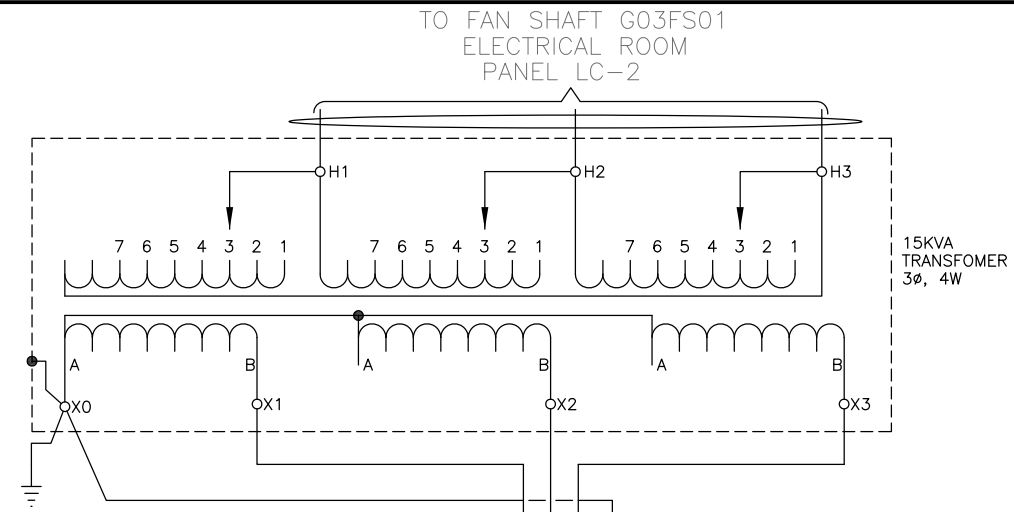

PANEL NAME: PANEL LC-2B		LOCATION: 67TH AVE. TIE BREAKER STATION									
PANEL TYPE: DISTRIBUTION		MAIN: 60A MCB									
BUS RATING: 100A, 208V/120V 3Ø, 4W GND & NEU BUS		PANEL: SURFACE MOUNTED									
DESCRIPTION	CONNECTED LOAD (KVA)			CKT BKR TRIP	CKT NO.	CKT NO.	CKT BKR TRIP	CONNECTED LOAD (KVA)			DESCRIPTION
	AØ	BØ	CØ					AØ	BØ	CØ	
ISOLATION TRANSFORMER	0			20	1	2	20	0	0	0	BATTERY CYCLE MONITOR
RTU		0		20	3	4	20		0		SPARE
SPARE			0	20	5	6	20			0	SPARE
SPARE				20	7	8	20				SPARE
SPARE				20	9	10	20				SPARE
SPACE					11	12	20				SPACE
SPACE					13	14					SPACE
SPACE					15	16					SPACE
SPACE					17	18					SPACE
SPACE					19	20					SPACE
SPACE					21	22					SPACE
SPACE					23	24					SPACE
SUB-TOTAL		0	0	0				0	0	0	SUB-TOTAL
		TOTAL CONNECTED LOAD									
PHASE A	0	KVA									
PHASE B	0	KVA									
PHASE C	0	KVA									
	0.00	KVA									
	0.00	AMP									



"PROFESSIONAL CERTIFICATION: I HEREBY CERTIFY THAT THESE DOCUMENTS WERE PREPARED OR APPROVED BY ME, AND THAT I AM A DULY LICENSED PROFESSIONAL ENGINEER UNDER THE LAWS OF THE COMMONWEALTH OF VIRGINIA."
 LICENSE No. 04020117145
 EXPIRATION DATE: 10/31/2015
 -VA Regulations 18VAC10-20-760

DESIGNED JAJ 4/4/15 DRAWN JAJ 5/20/15 CHECKED PK 6/1/15		REFERENCE DRAWINGS NUMBER TITLE DATE NUM DESCRIPTION 11/2/15 Δ AMENDMENT NO. 1	REVISIONS DATE NUM DESCRIPTION 11/2/15 Δ AMENDMENT NO. 1	WASHINGTON METROPOLITAN AREA TRANSIT AUTHORITY DEPARTMENT OF TRANSIT INFRASTRUCTURE AND ENGINEERING SERVICES CENI - POWER SYSTEMS ENGINEERING	SIX (6) TIE BREAKER STATIONS UPGRADES ORANGE AND BLUE LINES DC, MD AND VA G02TB2 - 67TH AVE. TIE BREAKER STATION PANELBOARD SCHEDULES	CONTRACT NO. FQ15237 SCALE NONE DRAWING NO. G02TB2-TB-500 SHEET NO. 60 OF 60
		REVISION SUBMITTED _____ APPROVED _____ DATE DEPUTY CHIEF ENGINEER DATE		CONTRACT NO. FQ15237 SCALE NONE DRAWING NO. G02TB2-TB-500 SHEET NO. 60 OF 60		